


# T 9 S, R 2 E, WM

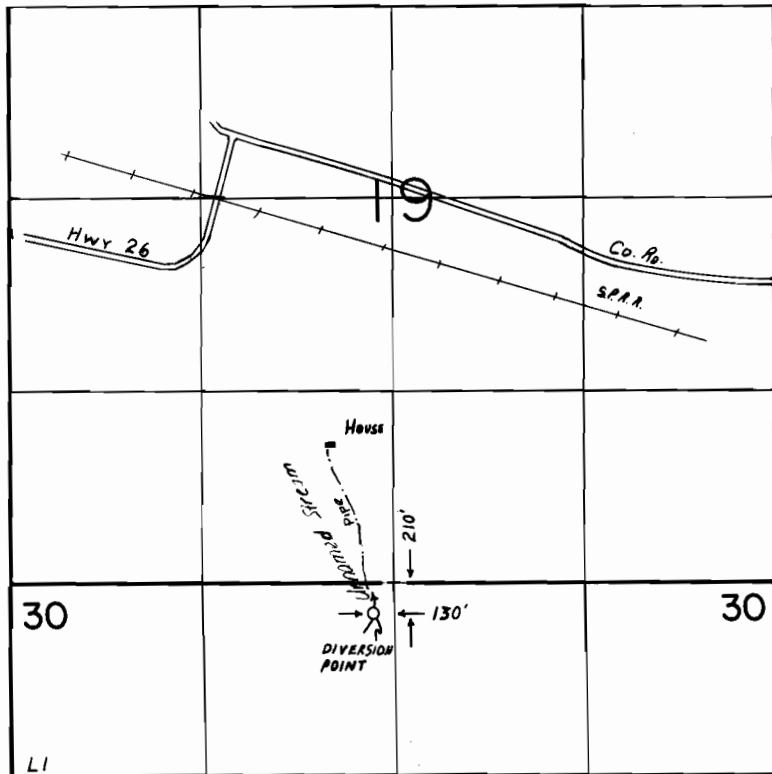

SCALE  
1" = 1320'

## FINAL PROOF SURVEY UNDER

Application No. 68598.. Permit No. 49505.....  
IN NAME OF

.....JOHN A. PRIDEAUX.....

Surveyed MAY 7, 1986., by T. M. WARREN.....