
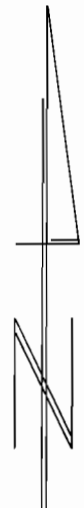


T9S, R6W, WM

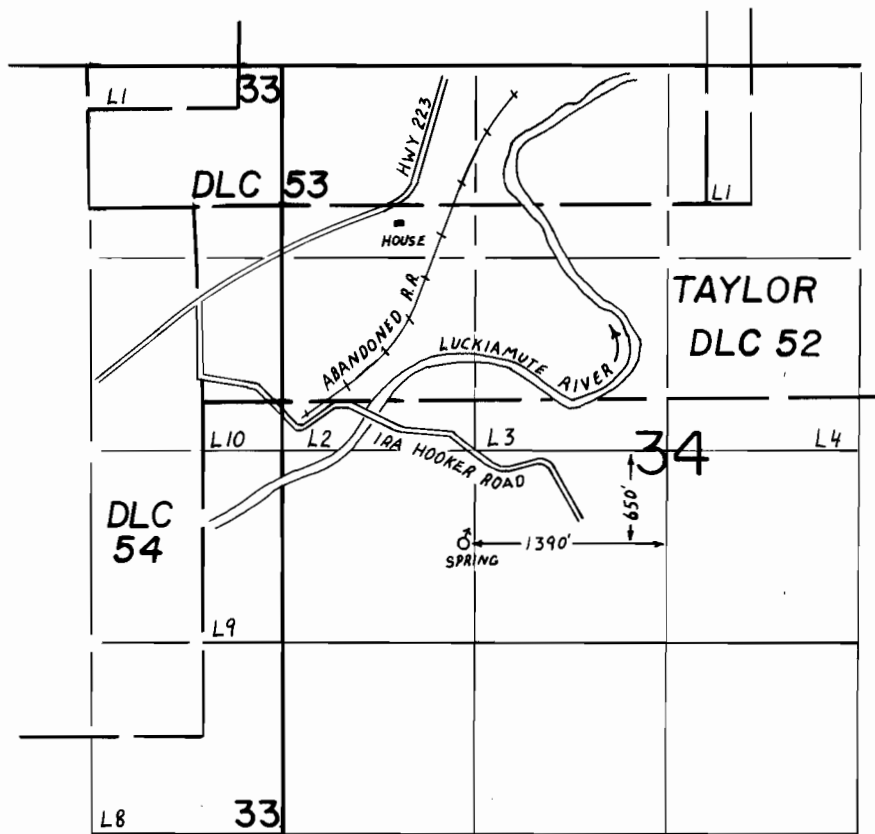

SCALE
1" = 1320'

FINAL PROOF SURVEY
UNDER

Application No. 68972.. Permit No. 49979.....
IN NAME OF

PEDEE MEMORIAL EVANGELICAL CHURCH OF NORTH AMERICA

Surveyed MAR...24. 1988., by T. M. WARREN..