


T1&2N, R14E, WM

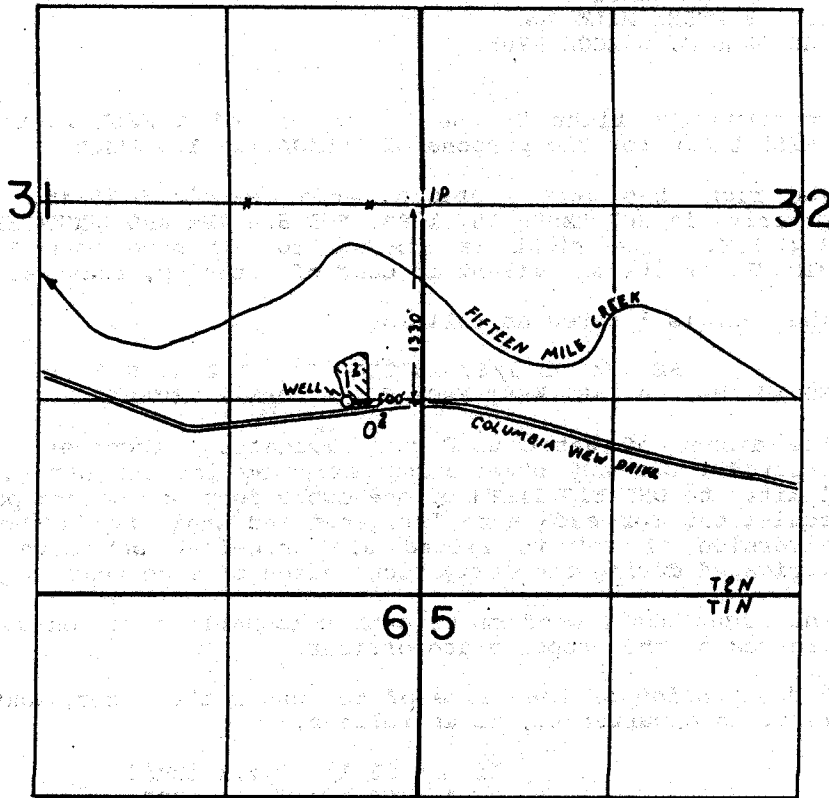

SCALE:
1" = 1320'

FINAL PROOF SURVEY UNDER

Application No. G-11094 Permit No. G-10345.
IN NAME OF

.....RICHARD L. MARTIN.....

Surveyed APRIL 13, 1988, by T.M. WARREN.