


T.28S. R.11W. W.M.

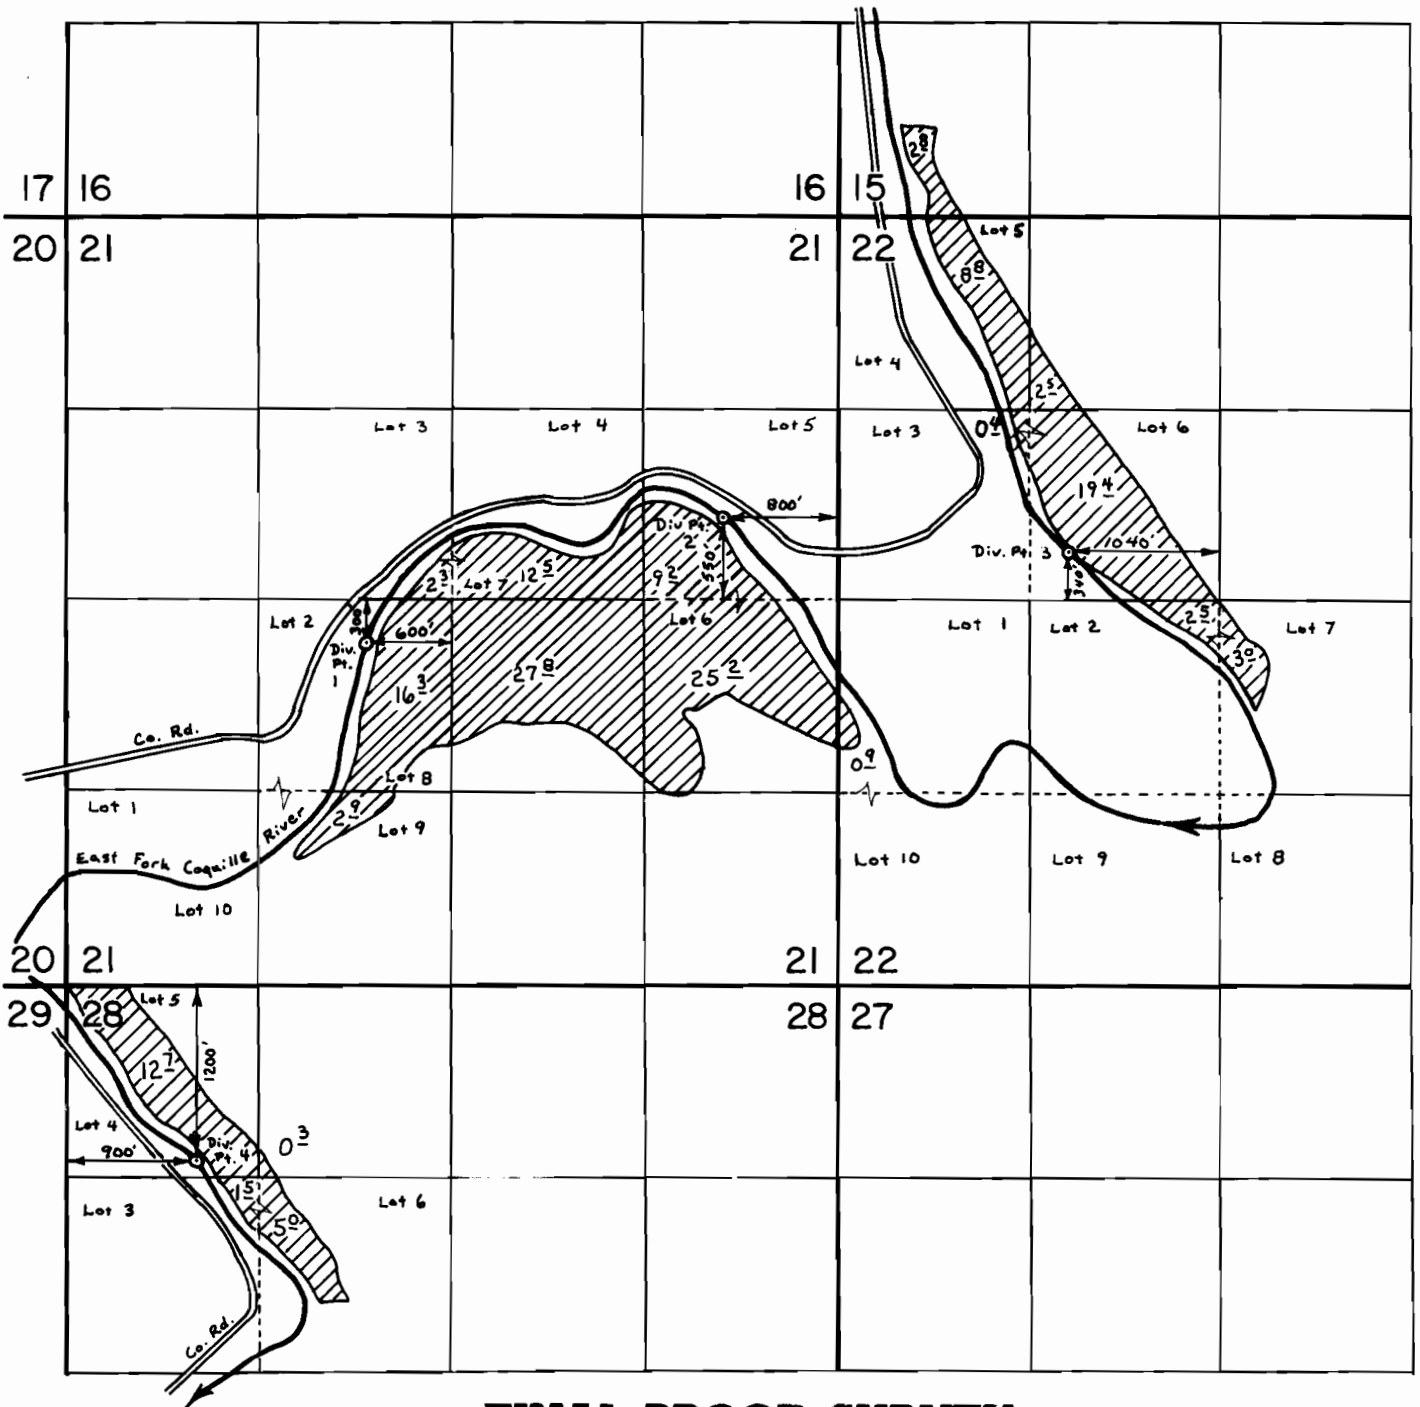

FINAL PROOF SURVEY UNDER

SCALE: 4" = 1 mi.

Application No. 52503 Permit No. 37825
IN NAME OF

MENASHA CORPORATION and JERRY C. & JANICE A. SMITH

Surveyed May 17, 1978, by D. Sparks
Nov. 21, 1988, by B. S. JAMES