

UNITED STATES  
DEPARTMENT OF THE INTERIOR  
BUREAU OF LAND MANAGEMENT

SECTION


20


TOWNSHIP 23s, RANGE 30e, W. M.

North

*From section*

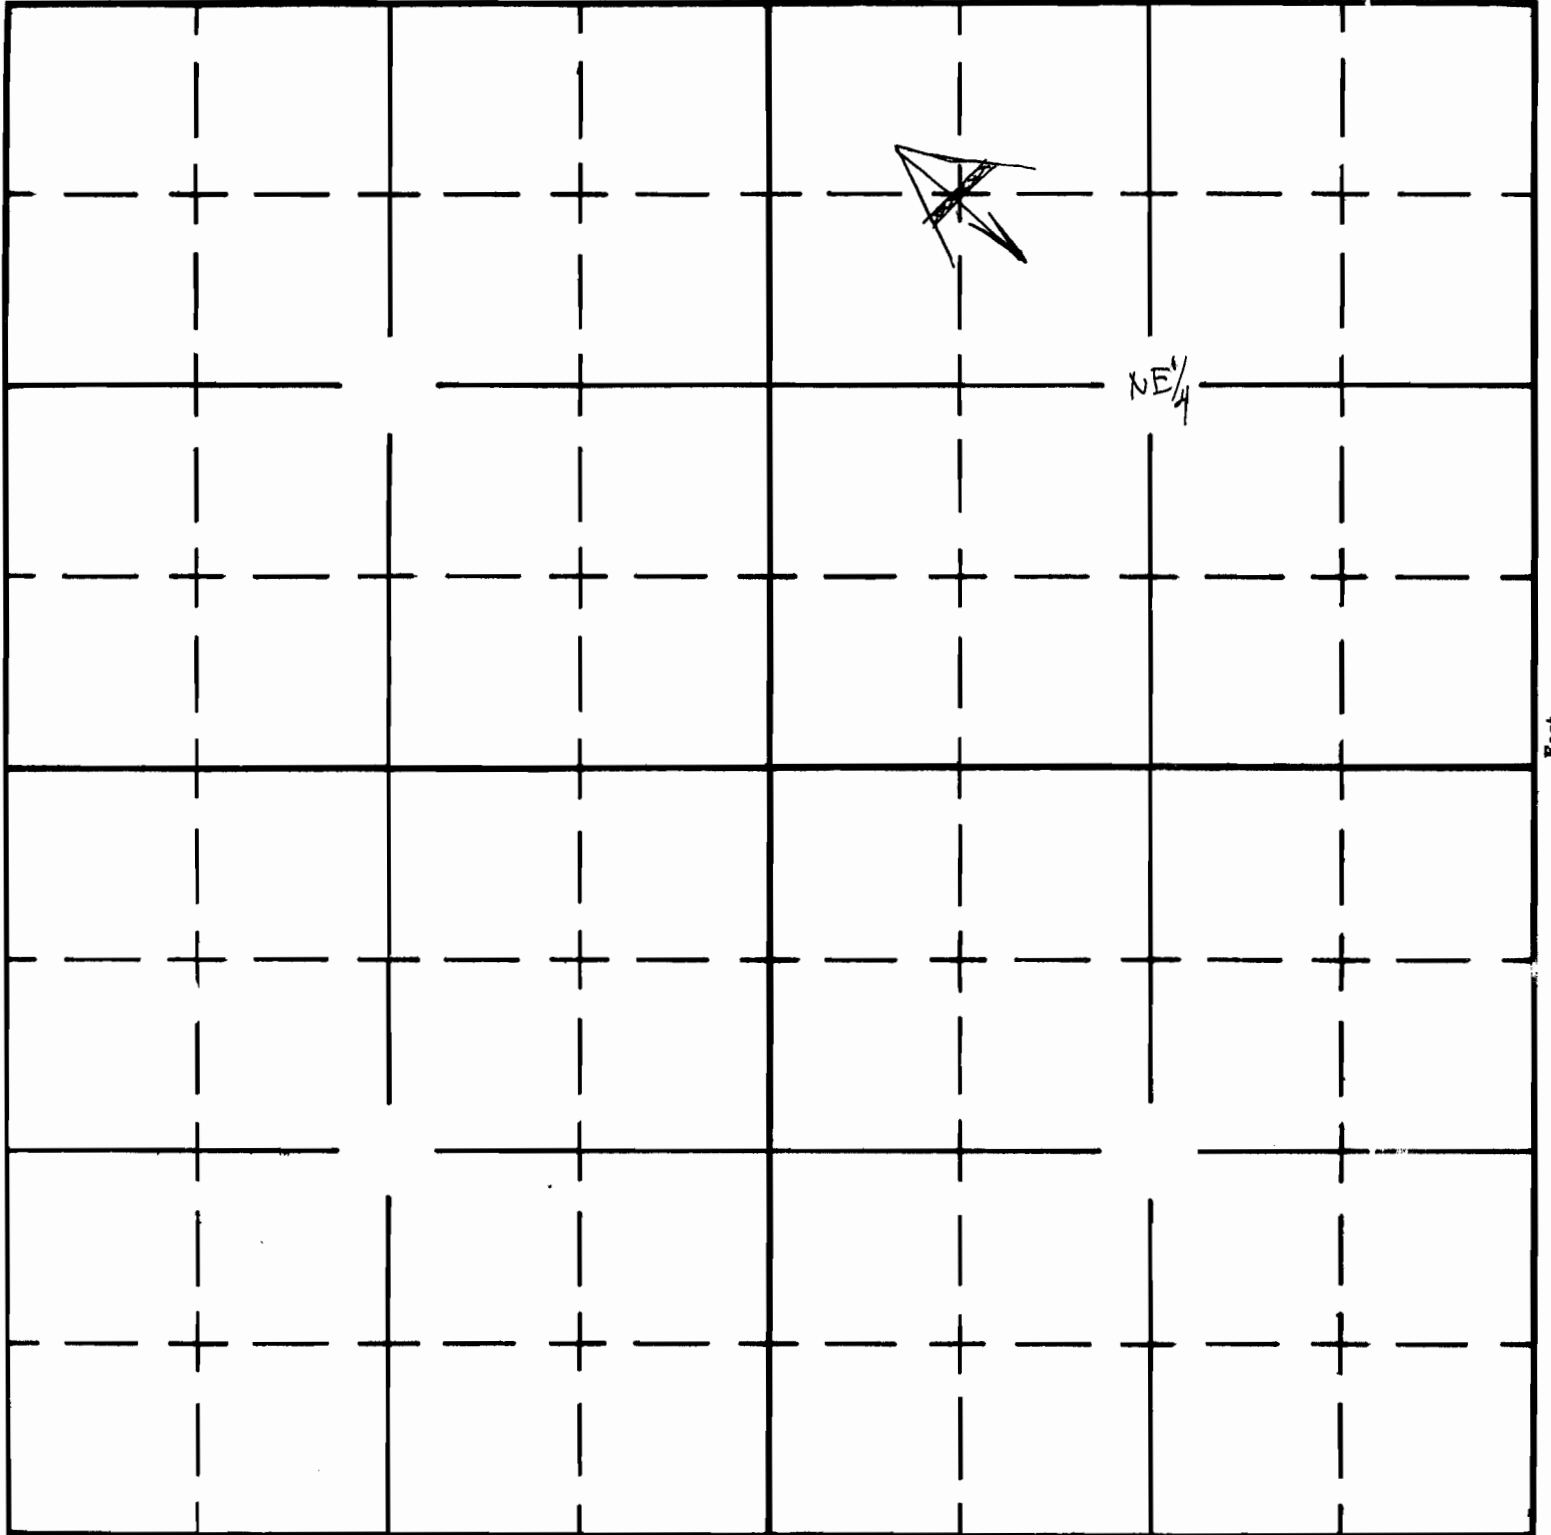

South

APPLICATION No. *R-38302*

PERMIT No. *R-3190*