


G 5092
62326

T. IN. R. 26E. WM.

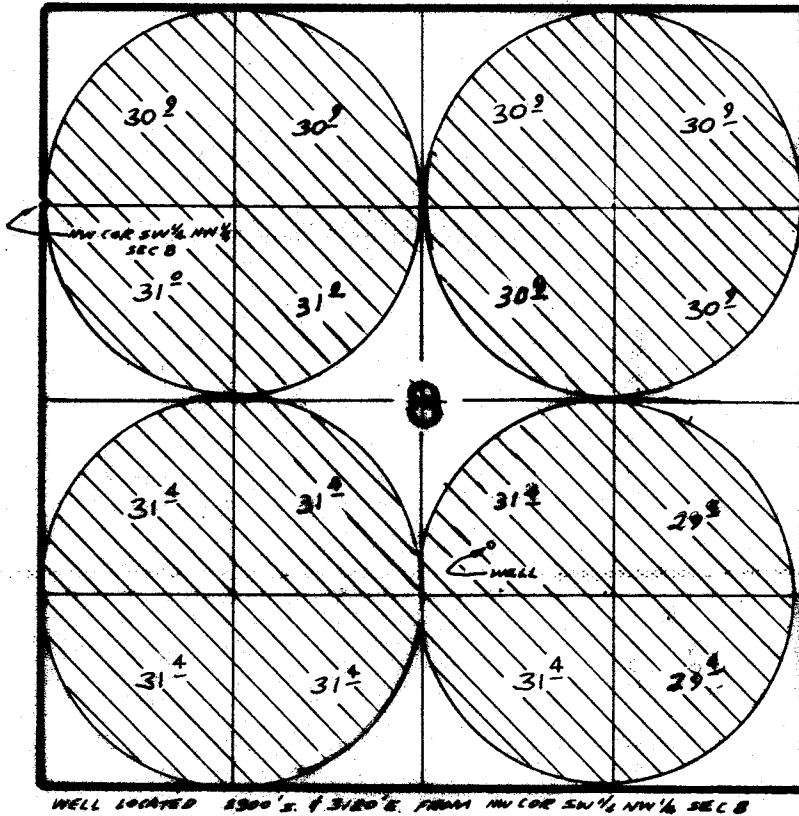

FINAL PROOF SURVEY UNDER

Application No. G-5235. Permit No. G-5092
IN NAME OF

.....MRS. WM. J. DOHERTY.....

Surveyed 2-8..... 1978, by P. F. BARNIN.....
2-28..... 80 V. Church

272-285
PTS-1980-P-1