


T. 15S. R. 4W.W. M.

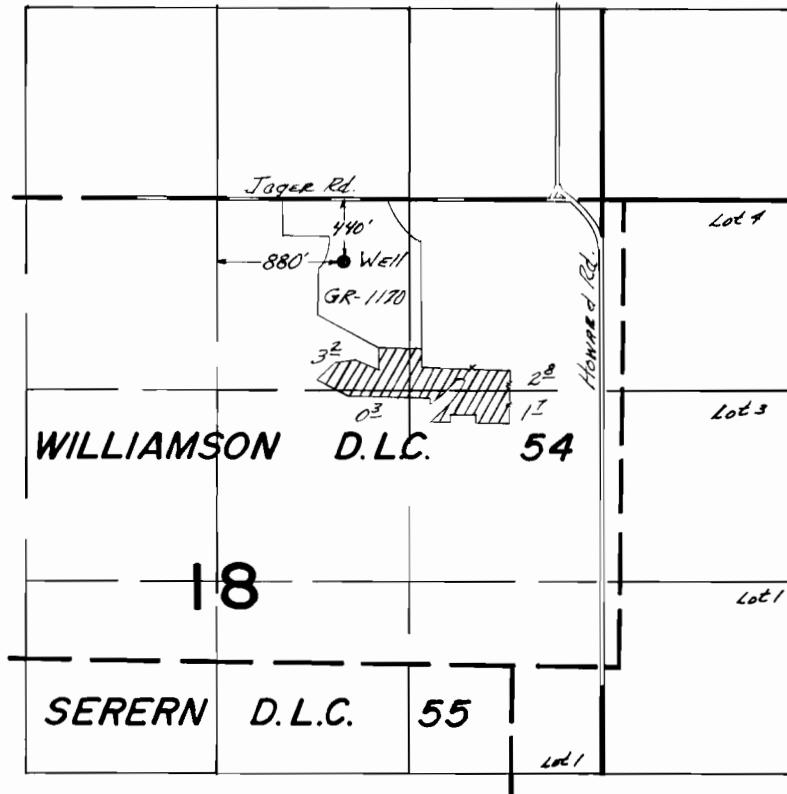

FINAL PROOF SURVEY
UNDER

Application No. G-6831. Permit No. G-8008
IN NAME OF

LOREN & ALETA SIMMONS

Surveyed Oct. 10, 1979, by C.R. RODRIGUEZ