


T.18S.,R.45E.,W.M.

Section 28

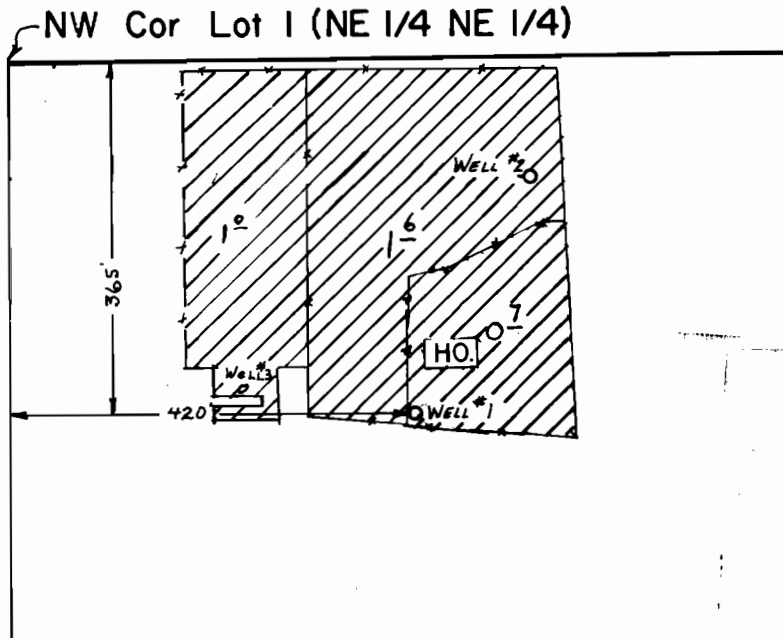

SCALE: 1" = 200'

FINAL PROOF SURVEY UNDER

Application No. G-6930 Permit No. G-6448
IN NAME OF

HERMAN OLSEN

Surveyed Aug. 23, 19.83, by L. M. TOLL
4-18 88 V.L. Church