


# T.7S. R.3W., W.M.

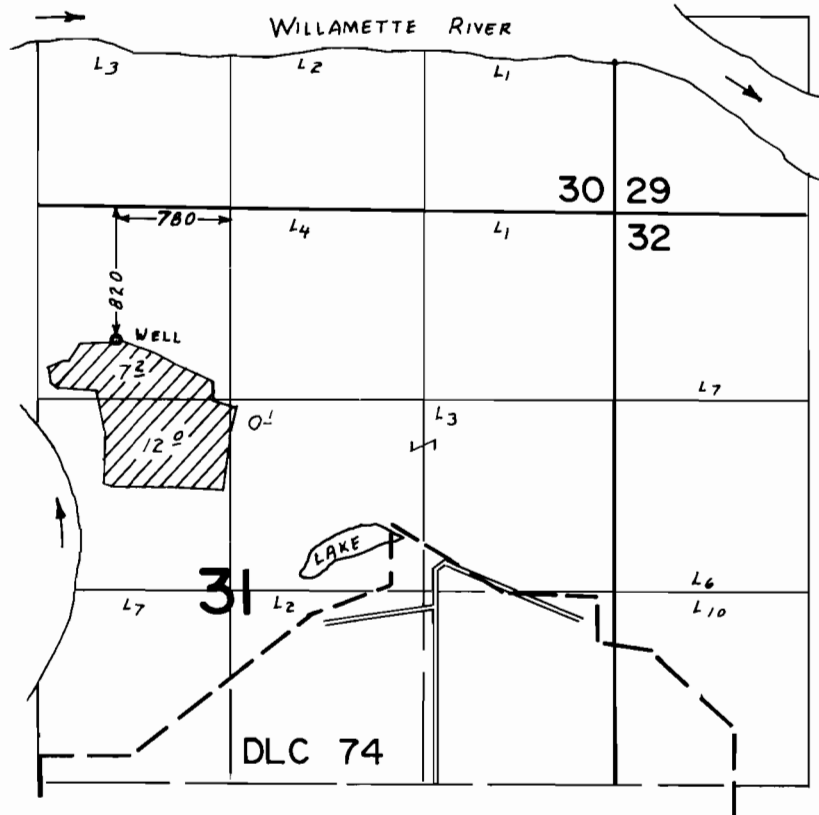

## FINAL PROOF SURVEY UNDER

Application No. ~~G-7934~~ Permit No. G-7320.....  
IN NAME OF

KARL HEYDEN

Surveyed MAY 30, 1979., by L. H. NUNN.....