


G 8115

62333

# T. 6N. R. 34E. W.M.

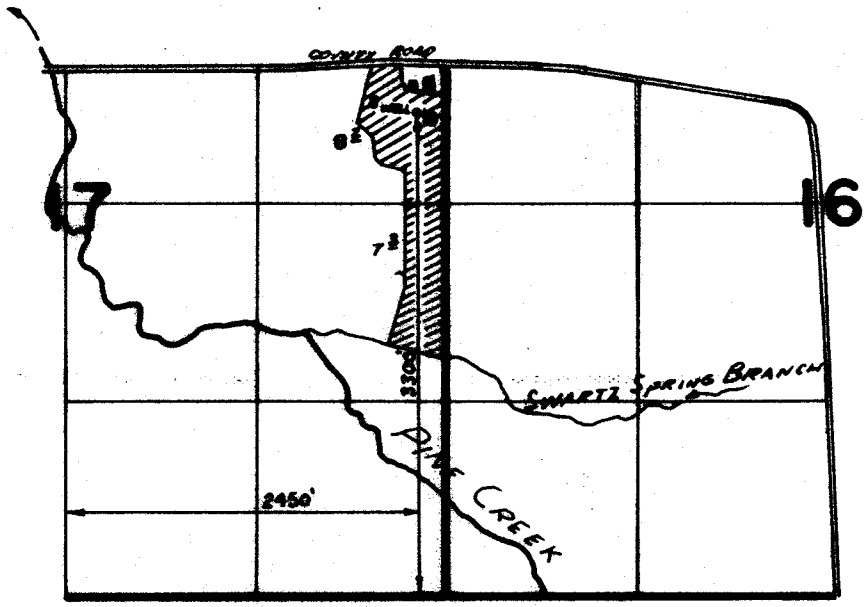

## FINAL PROOF SURVEY UNDER

Application No. G-8597 Permit No. G-8115  
IN NAME OF

RAYMOND BEVANS

Surveyed 6-26 1979 by J. Church