


T. 1S., R. 2&3W., W.M. .

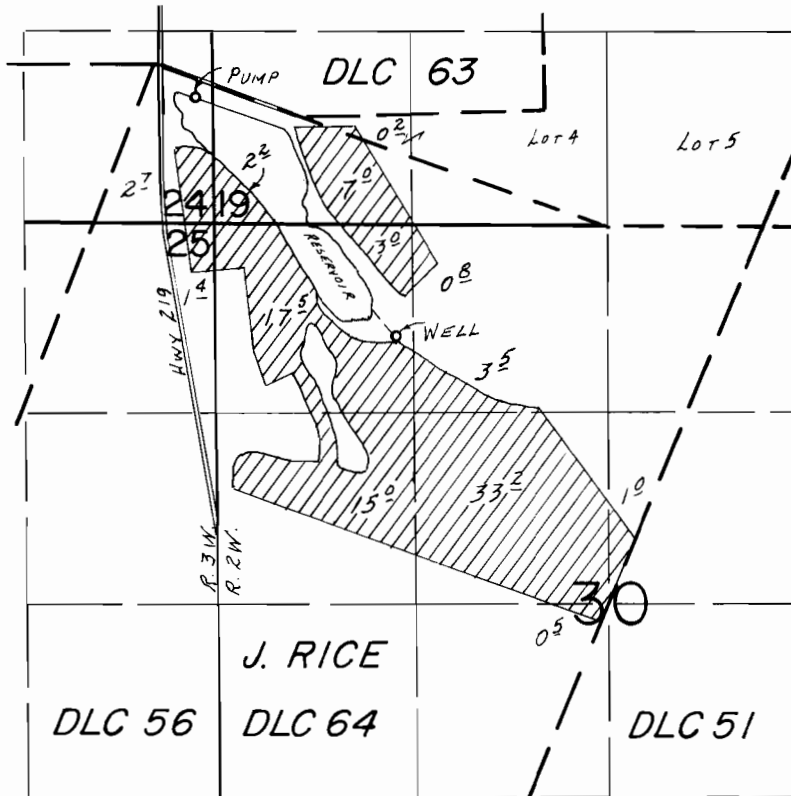

SCALE: 1" = 1320'

FINAL PROOF SURVEY UNDER

Application No. G-8656. Permit No. G-8212.....
IN NAME OF

FRANK H. & IRIS G. TANKERSLEY

Surveyed AUG. 25, 1986, by B.W. BISHOP.....

2-25-88 Bwb
41067-178-137A