


G 8044
62335

T. 1 S. R. 32 E. W.M.

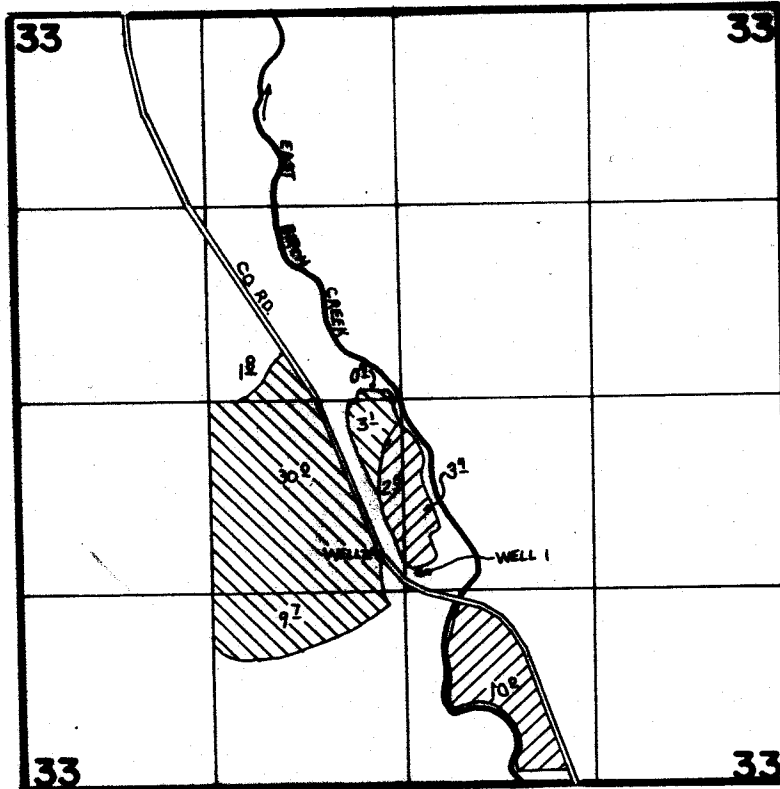

Scale 1"=1320'

6.2

WELL 1 LOC. 1180' S. / 90' E. FROM CENTER SEC. 33
WELL 2 LOC. 1036' S. / 220' W. FROM CENTER SEC. 33



PRIMARY



SUPPLEMENTAL

FINAL PROOF SURVEY UNDER

Application No. ~~G.8664~~ Permit No. G.8044.....
IN NAME OF

.....ORVILLE HUMPHREYS.....

Surveyed June 30, 1986., by J. Sauter.....