


G 8726
62336

T. 2N., R. 33E., W. M.

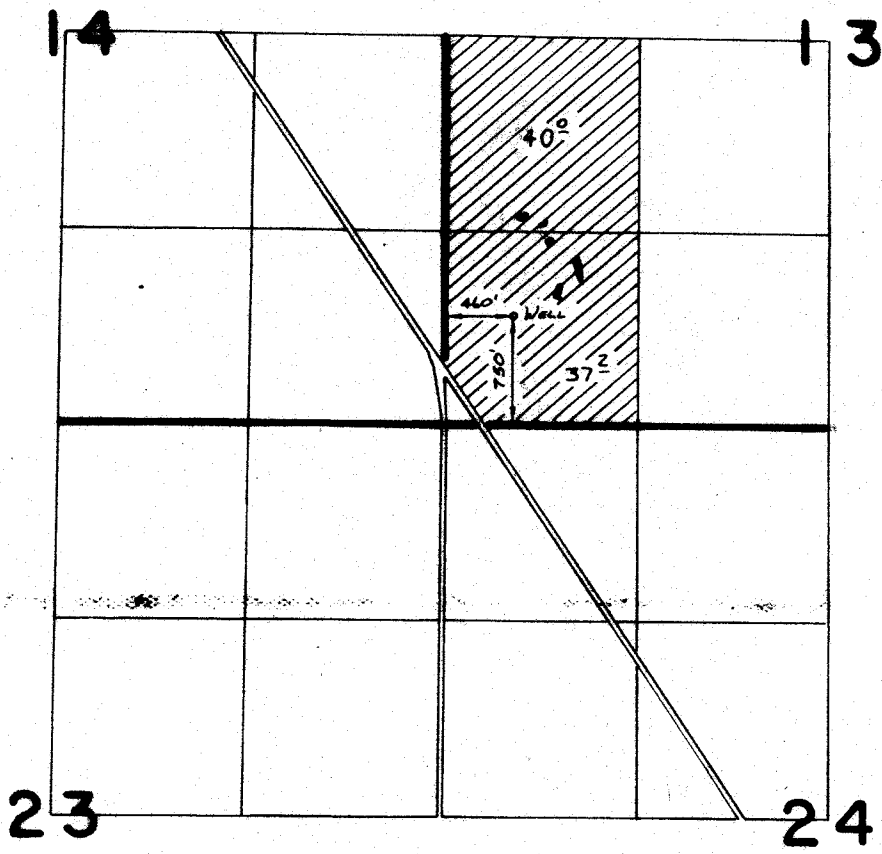

FINAL PROOF SURVEY UNDER

Application No. G: 8683 Permit No. G: 8726...
IN NAME OF

.....JERRY L. HAGUEWOOD.....

Surveyed *May 26*... 1983, by *V. L. Church*.....