


T. 35 S., R. 2 W., W. M.

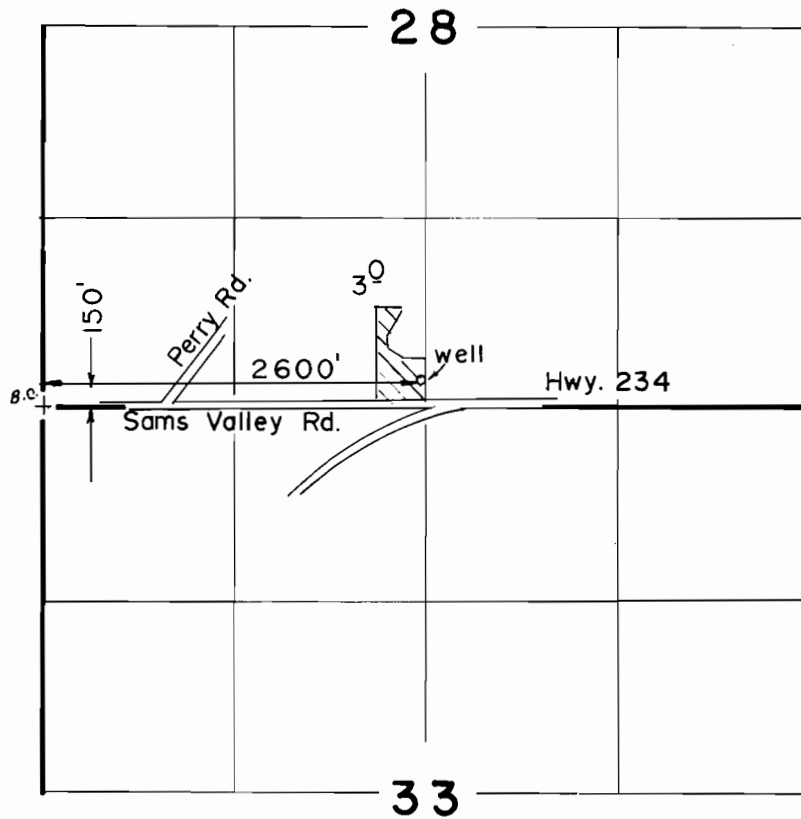

**FINAL PROOF SURVEY**  
UNDER

Application No. ~~G-897.7~~ Permit No. ~~G-8382~~  
IN NAME OF

GLENN.....M.....&/OR.....LAURENA.....HOLLISTER

Surveyed MAY 30 1987, by B. S. JAMES.