



T.10S., R.38E., W.M.

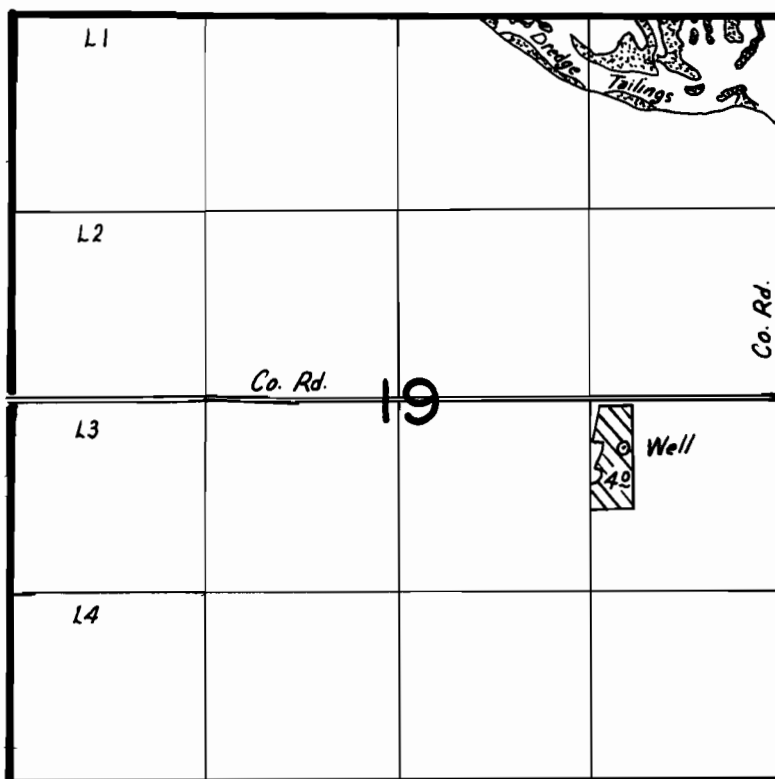

The location of the well is 2280' N. &
1100' W. from SE cor. sec. 19.

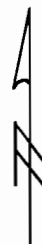

Scale: 1" = 1320'

FINAL PROOF SURVEY

UNDER

Application No. G9336 Permit No. G8730
IN NAME OF

RICHARD J. SHEENY & T.R. BUNCH.

Surveyed 9-30 1987, by Vern Church