


T. 4 S., R. 2 W., W. M.

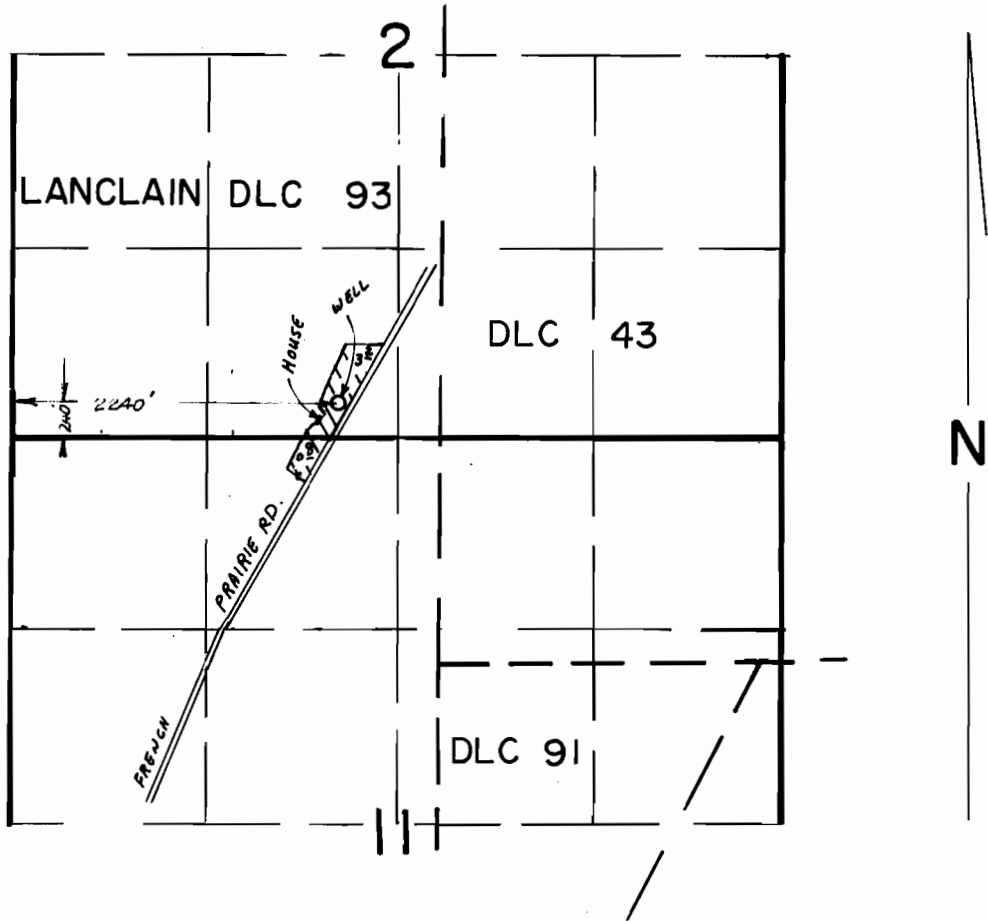

SCALE 1" = 1320'

FINAL PROOF SURVEY
UNDER

Application No. G-11117 Permit No. G-10254
IN NAME OF

GARY L. & MARY L. GETSINGER

Surveyed AUG 2 1988 by Z. SALEH

DFN-6LL-188
1-12-89 Z.F.S.