


T. 7 S., R. 2 W., W. M.

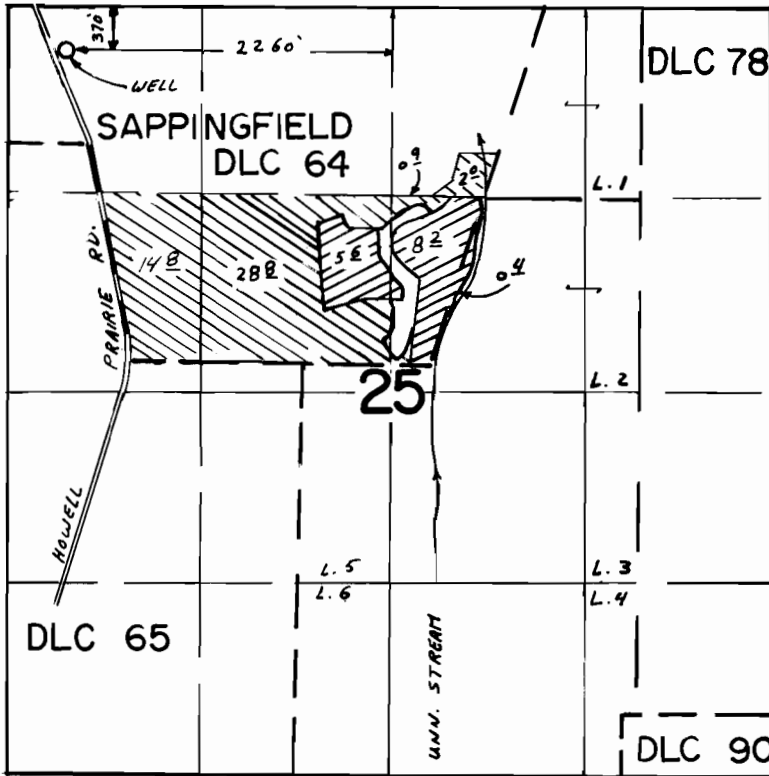

PRIMARY



SUPPLEMENTAL

SCALE 1" = 1320'

FINAL PROOF SURVEY

UNDER

Application No. **G-11357** Permit No. **G-10480**

IN NAME OF

CLARENCE SIMMONS

Surveyed **JUL 6 1988** by **Z. SALEH**