


T.7W., R.2W., W.M.

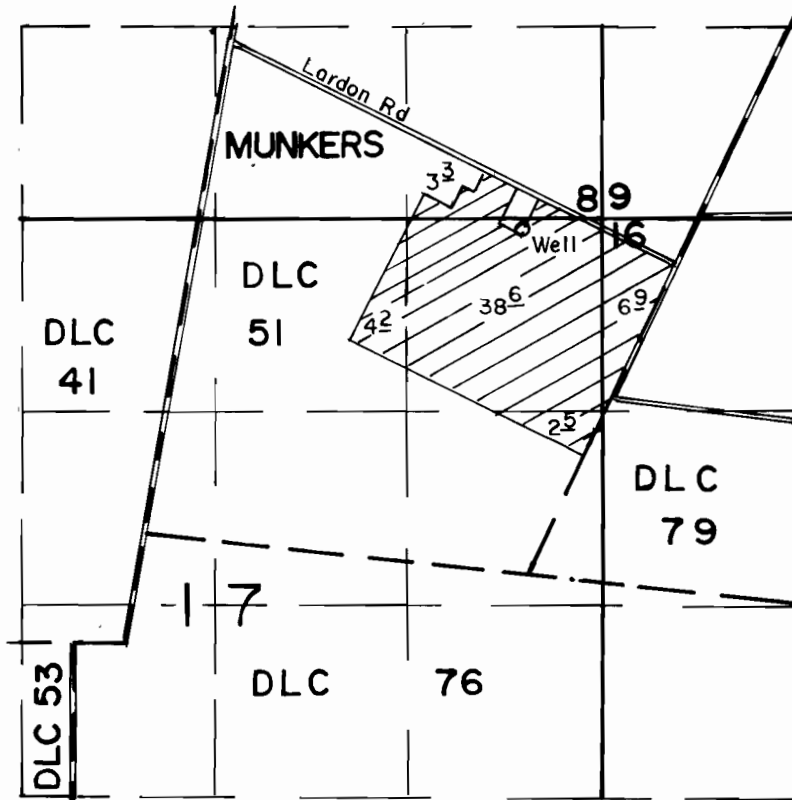

Well Located 100' S & 550' W From NE Corner Section 17

SCALE: 1" = 1320'

FINAL PROOF SURVEY
UNDER

Application No. G-11667... Permit No. G-10761.....
IN NAME OF

.....**RAY SATTER**.....

Surveyed JULY...6... 1988... by ...Z.F...SALEH.....