




T. 23 S., R. 12 W., W.M.

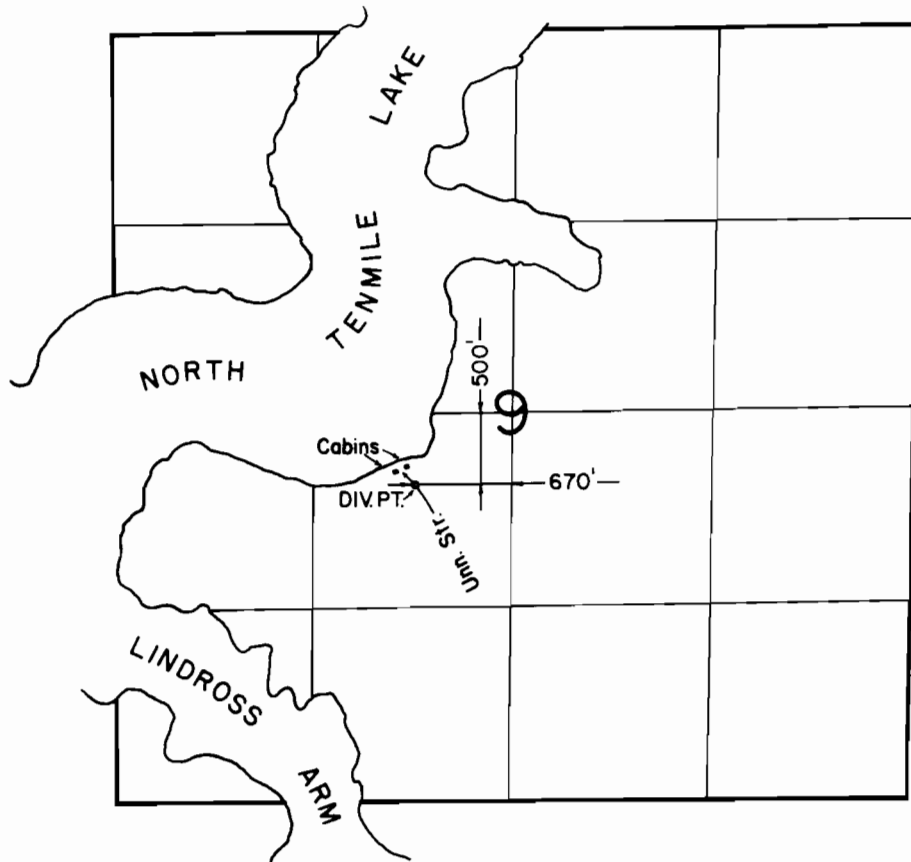

SCALE: 1" = 1320'

FINAL PROOF SURVEY UNDER

Application No. 49151 Permit No. 36853
IN NAME OF

PATRICIA DELANEY & KEN RAYE

Surveyed SEPT. 20 1988, by T. M. WARREN