


T. 15S. R. 30E. W. M.

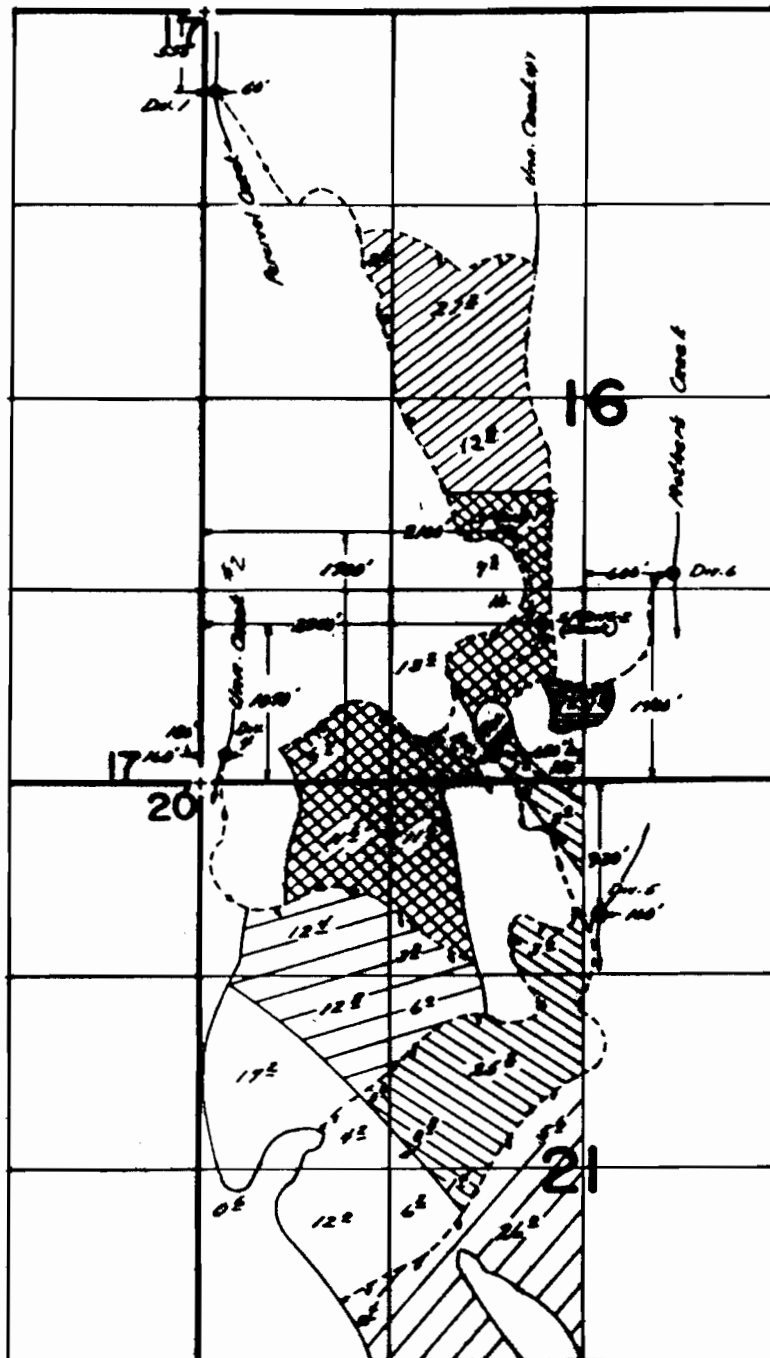


Percival Creek


Unnamed Creek #1
& Percival Creek


Mothers Creek


Unnamed Creek #1
& Percival, Mothers Creeks


Unnamed Creek #2
& Percival Creek


Mothers Creek
& Percival Creek

FINAL PROOF SURVEY
UNDER

R-49901 R-6746
Application No. 49341. Permit No. 42537....
IN NAME OF

.....IVAN PORFELY.....

Surveyed Sept. 18.. 1979, by S.C. BROWN.....

4023A-1876-147 LOR