

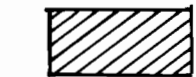


T. 15S. R. 30E. W. M.

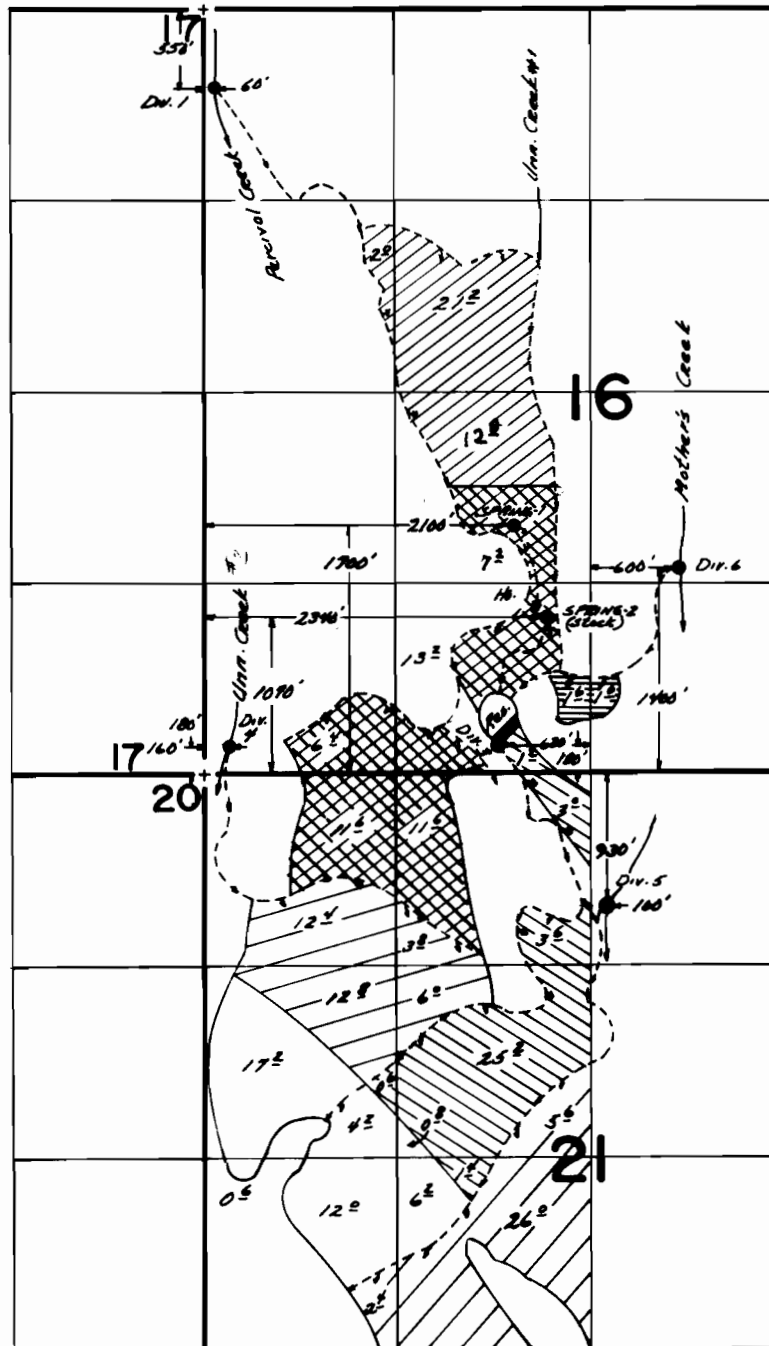

Percival Creek

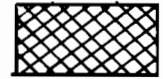

Unnamed Creek #1  
& Percival Creek



Mothers Creek



Unnamed Creek #1  
& Percival, Mothers Creeks



Unnamed Creek #2  
& Percival Creek



Mothers Creek  
& Percival Creek

# FINAL PROOF SURVEY UNDER

R-49901 R-6746  
Application No. 4.9.3.4.I. Permit No. 4.25.3.7....  
IN NAME OF

.....IVAN PORFELY.....

Surveyed Sept. 18.. 1979, by S.C. BROWN.....