


T.17S., R.2W., W.M.

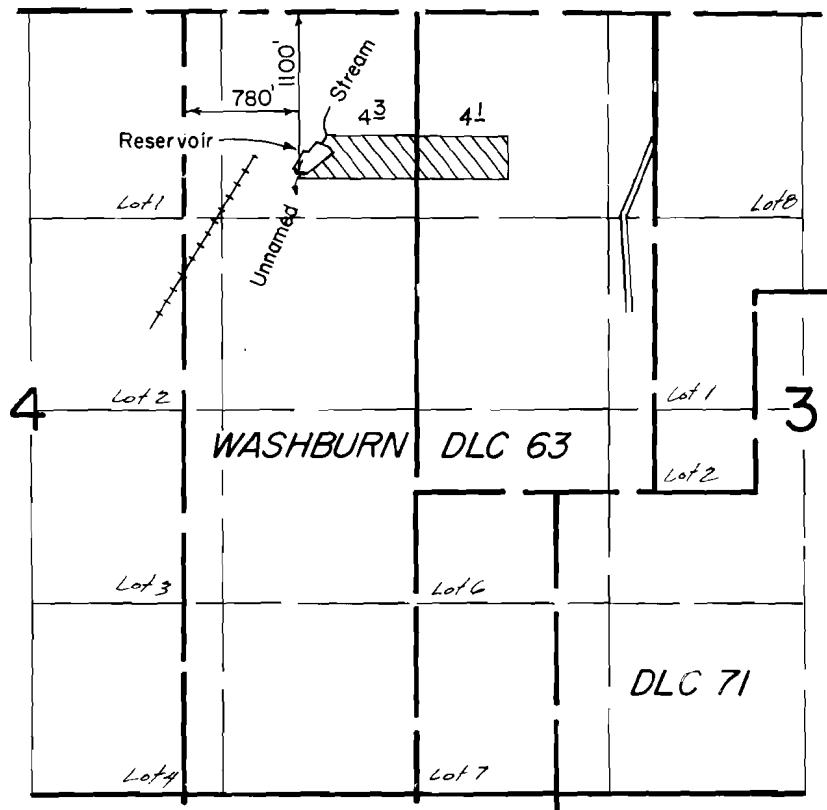

**FINAL PROOF SURVEY**  
UNDER

R-54076                      R-6455  
Application No. 54077      Permit No. 40490

IN NAME OF  
**KENNETH VIEGAS**

Surveyed JUNE 20, 1980, by C. L. HUGHES