


T.17S., R.2W., W.M.

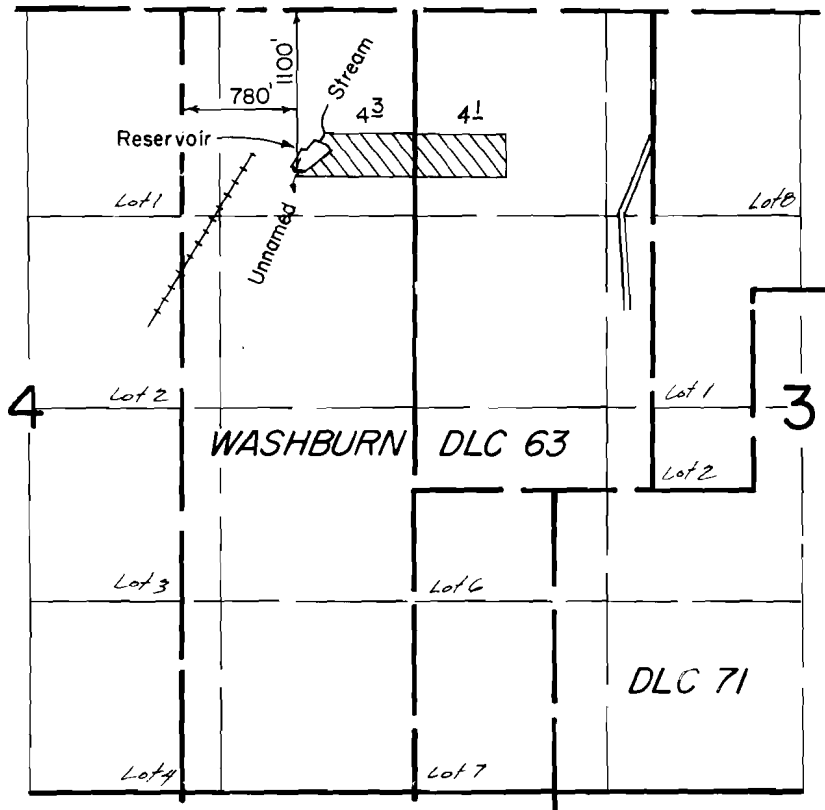

FINAL PROOF SURVEY UNDER

R-54076 R-6455
Application No. 54077 Permit No. 40490

IN NAME OF
KENNETH VIEGAS

Surveyed JUNE 20, 1980, by C. L. HUGHES