


T. 6S. R. 3W. W.M.

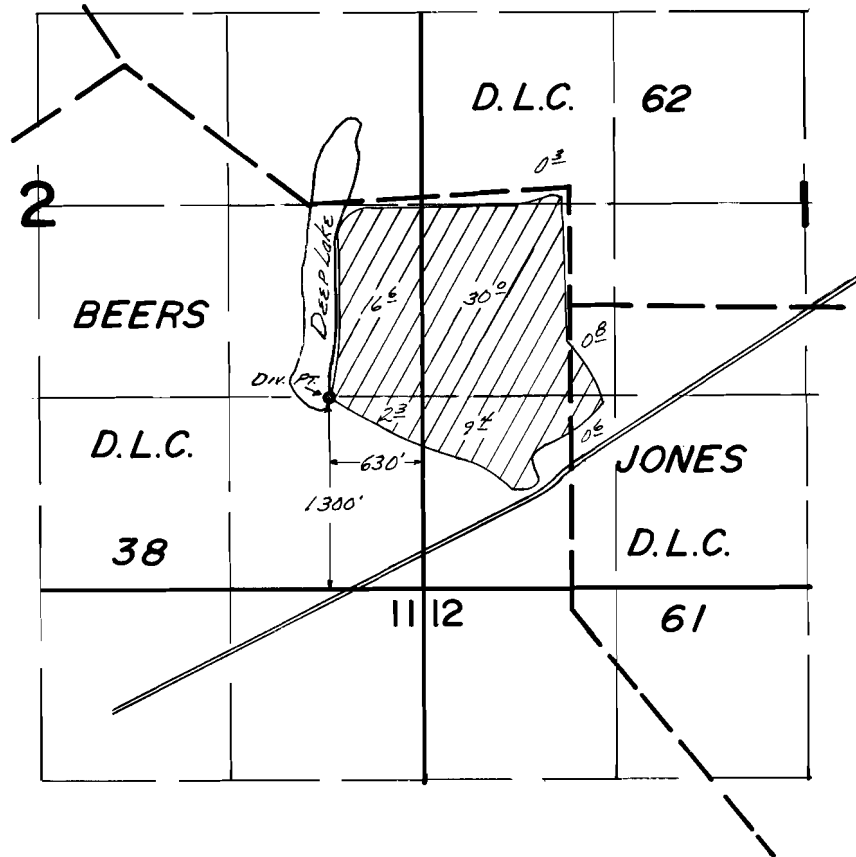

FINAL PROOF SURVEY
UNDER

Application No. 5532.1. Permit No. 43823.
IN NAME OF

.....DONALD JUNGWIRTH.....

Surveyed Sept. 4. 1979. by C.R.RODRIGUEZ