
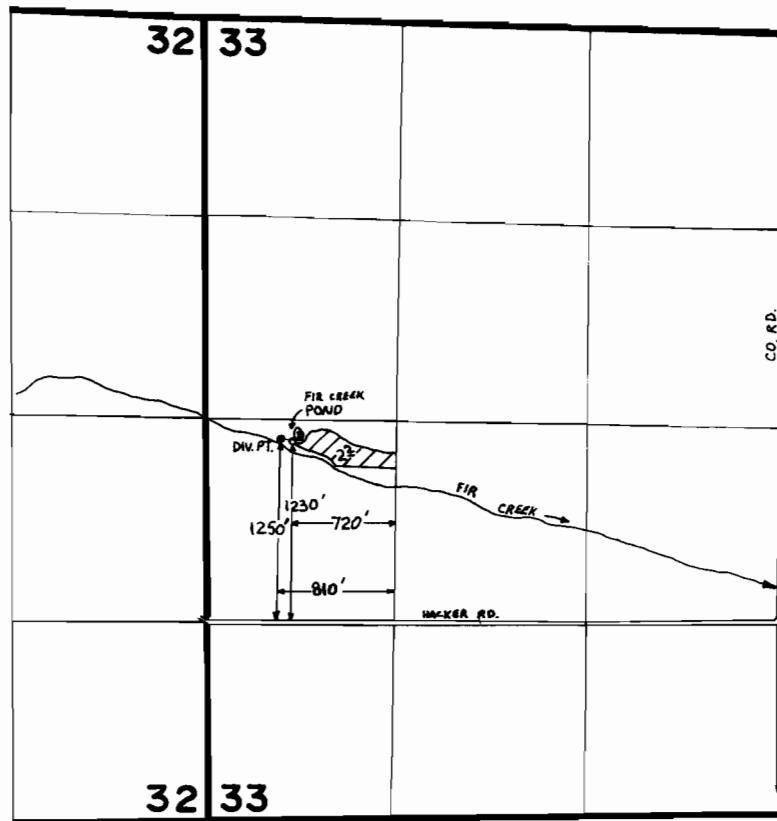


T. 1 N, R. 38 E, W.M.

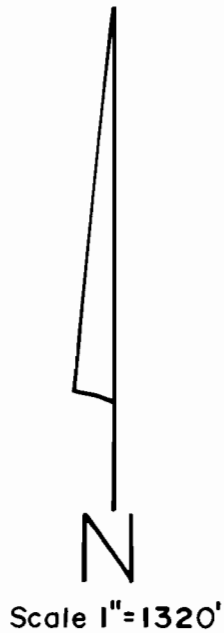

FINAL PROOF SURVEY UNDER

Copy

R-55350 R-6621
Application No. 56547 Permit No. 41970.....
IN NAME OF

FRANK M. GOSHORN

Surveyed April...2... 1987., by V. Church.....