



T. 1 N, R. 38 E. W.M.

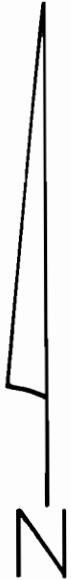

Scale 1"=1320'

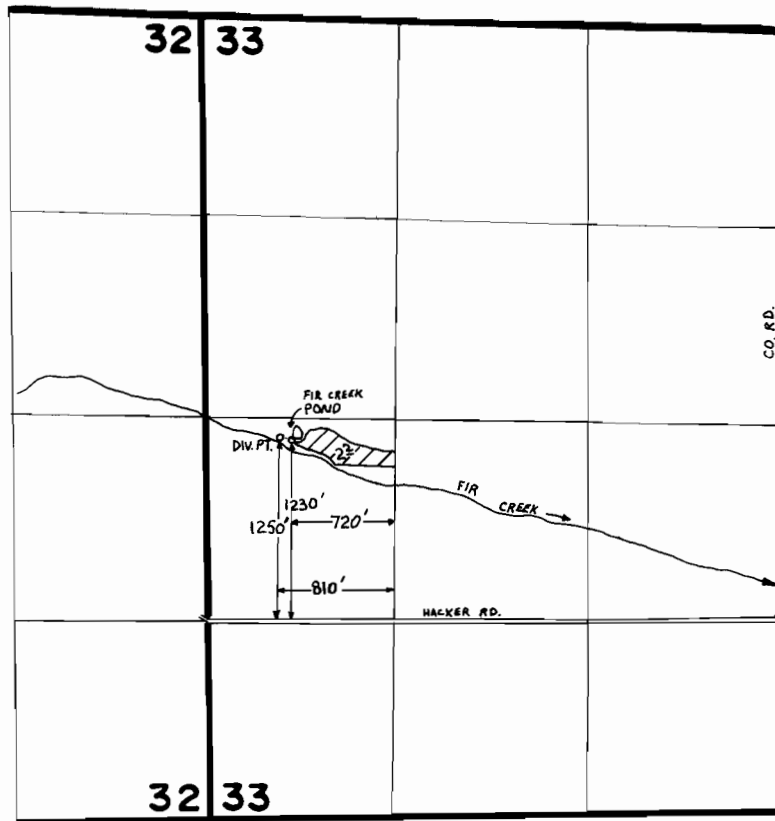

FINAL PROOF SURVEY UNDER

R-55350 R-6621
Application No. ~~56547~~ Permit No. ~~41970~~.....
IN NAME OF

.....**FRANK M. GOSHORN**.....

Surveyed April...2... 1987.., by V. Church.....