


T. 3 N. R. 36 E. W.M.

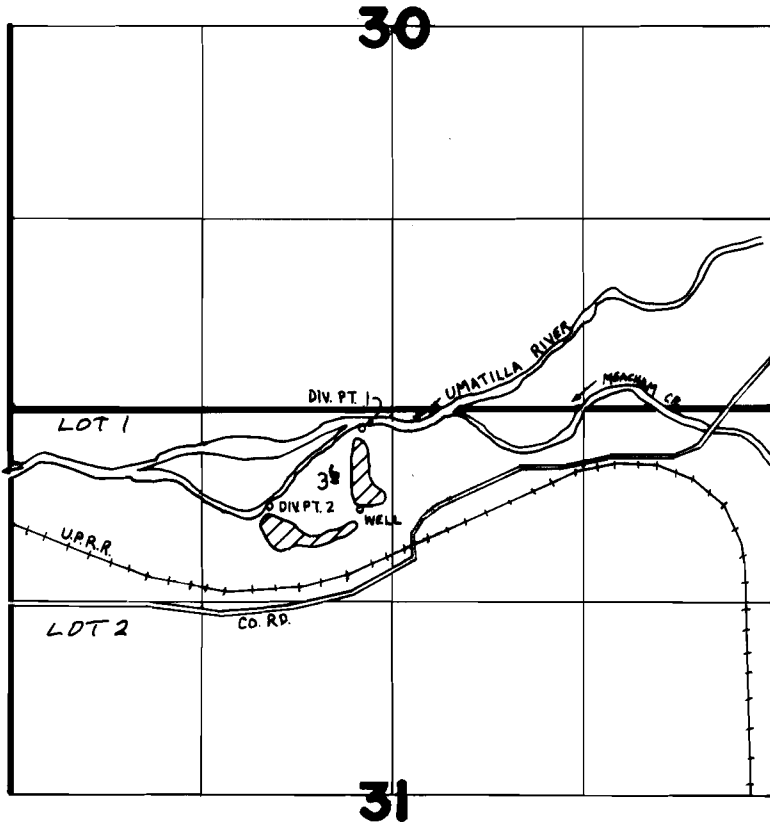

Scale 1" = 1320'



DIV. PT. 1 LOC. 130' S. & 200' W.
 DIV. PT. 2 LOC. 660' S. & 850' W. } FROM N. 1/4 COR. SEC. 31
 WELL LOC. 690' S. & 220' W. }

FINAL PROOF SURVEY UNDER

G 8765 G 8184
 Application No. ~~55827~~... Permit No. ~~41887~~.....
 IN NAME OF

EDWARD & ALBERTA L. CLARK

Surveyed March 2, 1907., by V. Church.....