


T. 1N., R. 4W., W.M.

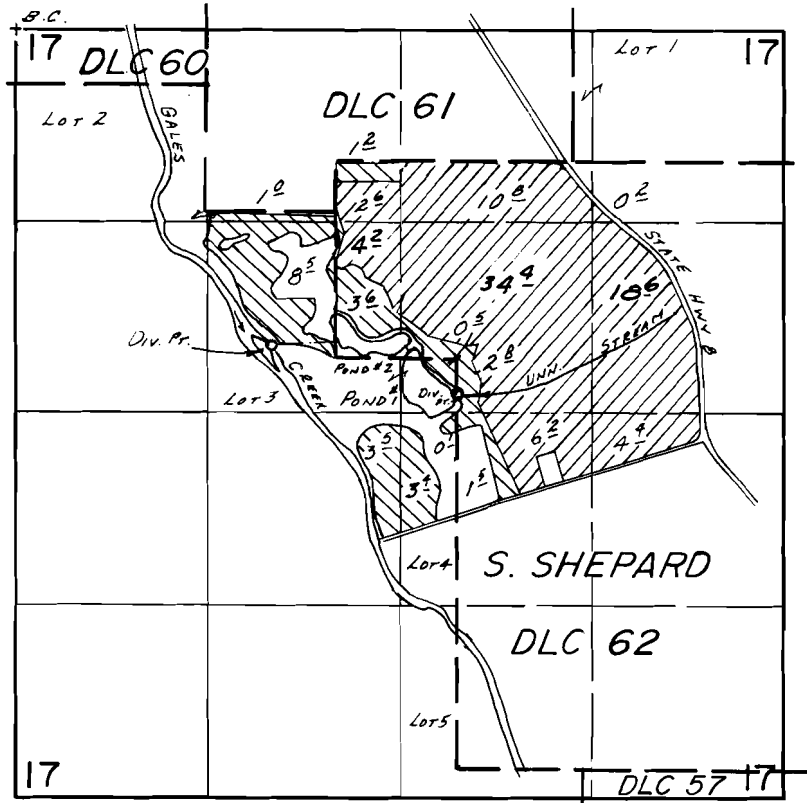


SCALE: 1" = 1320'

FINAL PROOF SURVEY UNDER

R-56386
56387

R-6676
42103

Application No. 56388. Permit No. 42104.....

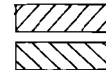

IN NAME OF

MELVIN E. & IRIS R. HOWELL.....

Surveyed Sept. 3.... 19.86, by B.W. BISHOP.....

1-23-87 BWS

41067-178-52L