


# T. 1N., R. 4W., W.M.

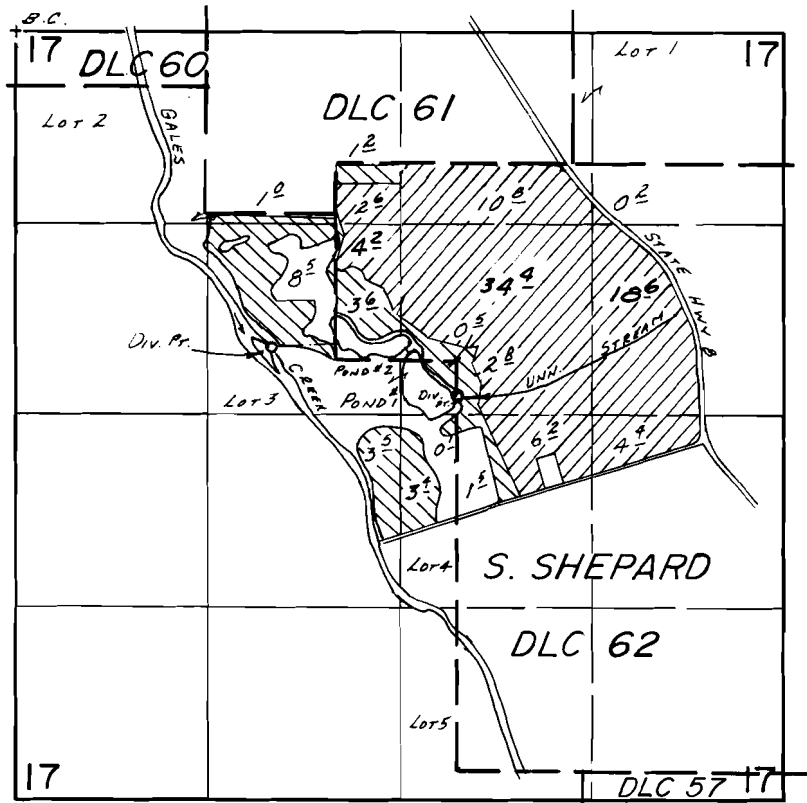


DIV. PT. LOC: GALES CREEK - 2170'S. & 1760'E, UNN STREAM - 2500'S. & 3050'E, BOTH FROM NW COR. SEC. 17.

SCALE: 1" = 1320'

## FINAL PROOF SURVEY UNDER

R-56386                      R-6676  
56387                        42103

Application No. 56388. Permit No. 42104.....

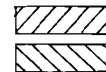

IN NAME OF

MELVIN E. & IRIS R. HOWELL.....

Surveyed Sept. 3.... 19.86, by B.W. BISHOP.....

1-23-87 BWS

41067-178-52L