




T. 23 S., R. 12 W., W.M.

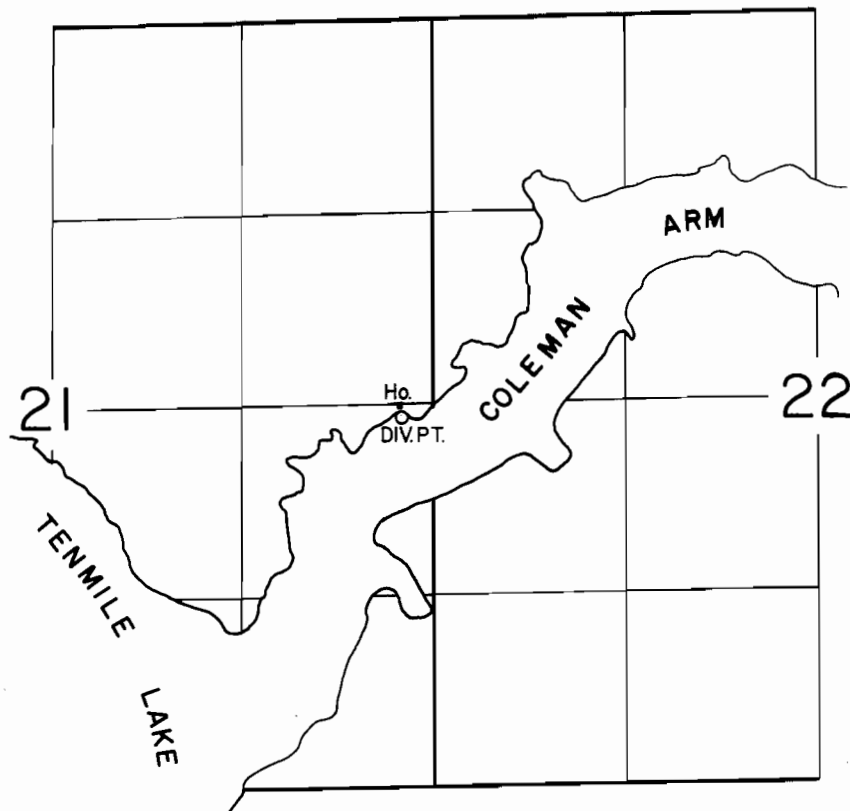

DIV. PT. LOC.: 80' S. & 210' W. FROM E. 1/4 CORNER SECTION 21

SCALE: 1" = 1320'

FINAL PROOF SURVEY UNDER

Application No. 57178... Permit No. 43019.....
IN NAME OF

JACK DONALD & LILLIAN JUNE GILHAM

Surveyed SEPT. 21, 1988, by V.L. CHURCH.....