


T13S, R5W, WM

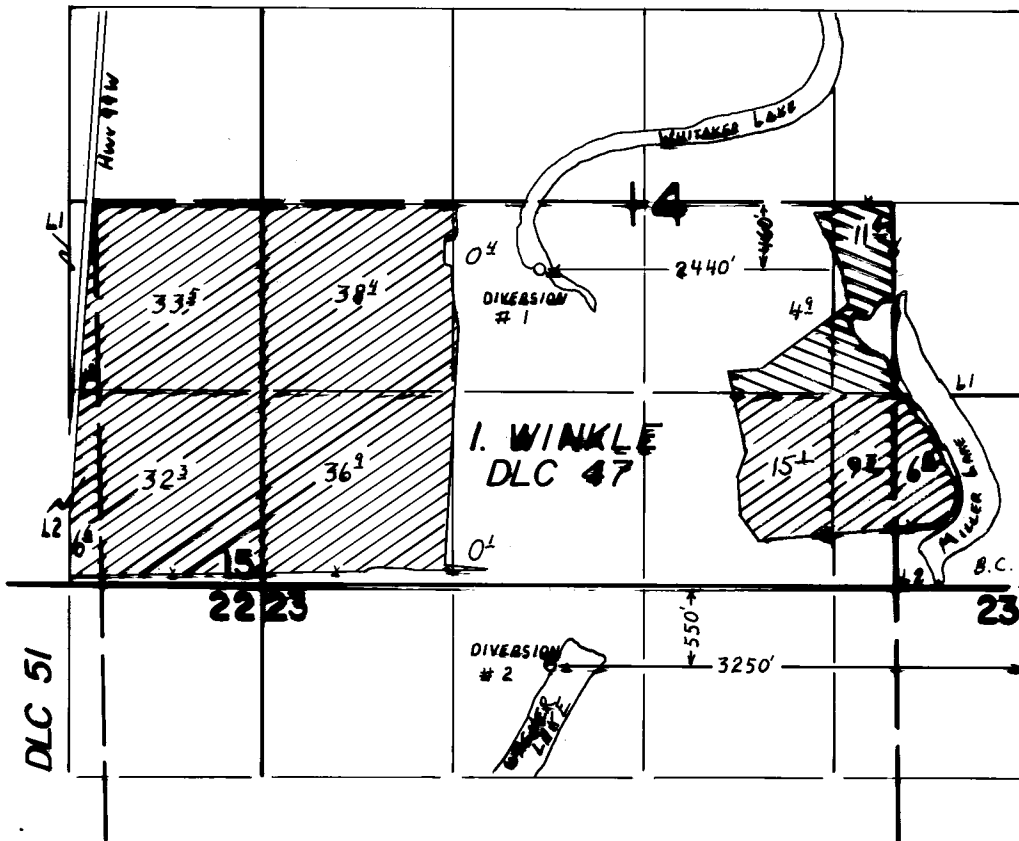

-  DIVERSION #1
-  DIVERSION #2

FINAL PROOF SURVEY UNDER

Application No. 57404. Permit No. 43176.....
IN NAME OF

RICHARD GUERBER.....

Surveyed AUG...11... 19.87., by T.M. WARREN...