
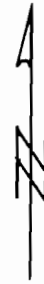


T.9S., R.39E., W.M.

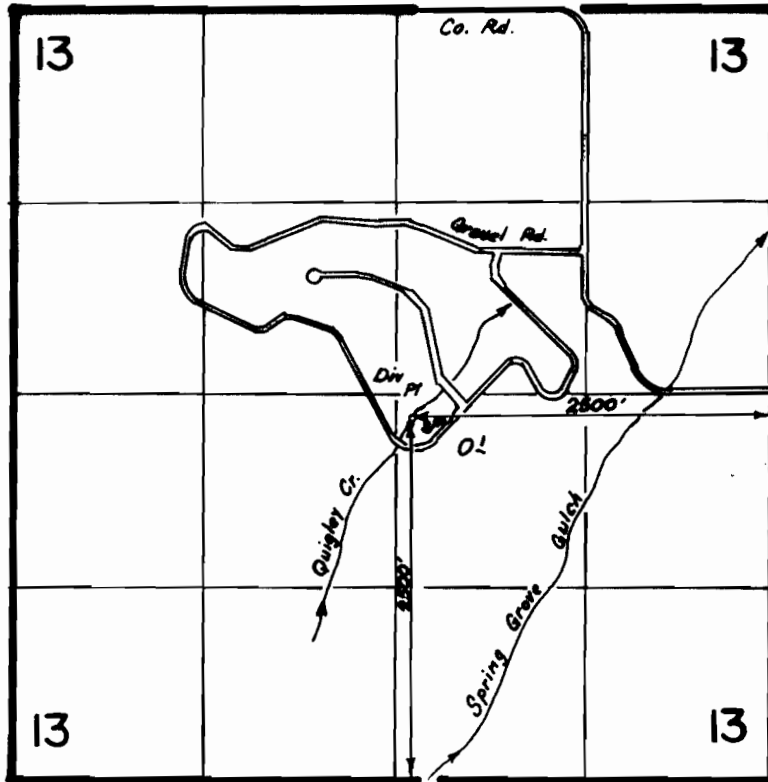

Scale: 1" = 1320'

FINAL PROOF SURVEY UNDER

Application No. 57420 Permit No. 43259
IN NAME OF

RONALD DEAN QUIGLEY

Surveyed 10-9-1987, by Vera Church