


T.6S., R.3W., W.M.

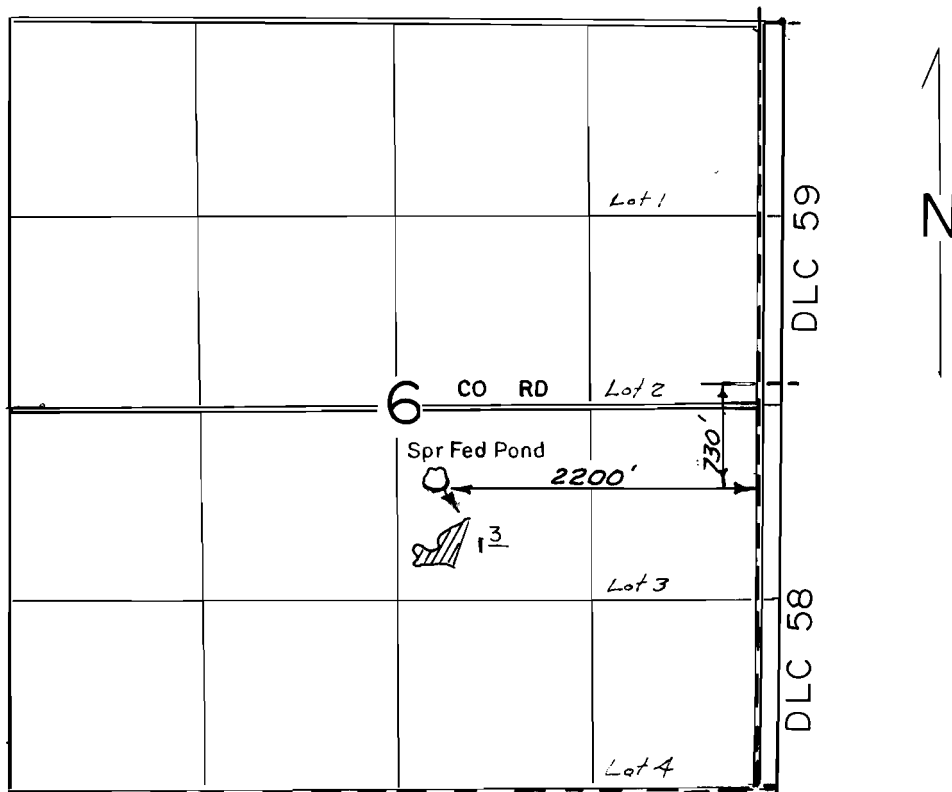

SCALE: 1" = 1320'

FINAL PROOF SURVEY
UNDER

R-57618 R-7691
Application No. 57619... Permit No. 43387....
IN NAME OF

.....LEONARD JOSEPH SAUNDERS.....

Surveyed .NOV.9.... 1987., by B.W. BISHOP.....