


T8S, R4W, WM

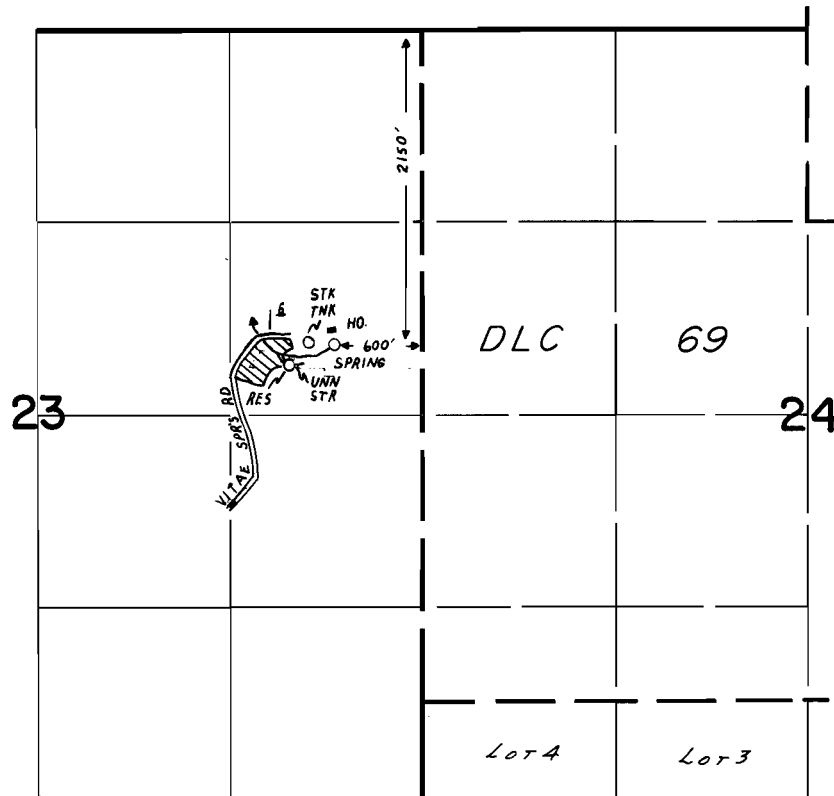

1" = 1320

RES. IS LOCATED 2290' S AND 910' W FROM THE NE CORNER SECTION 23

FINAL PROOF SURVEY UNDER

R-57748 R-7697
57749 43449
Application No. 57750 Permit No. 43516
IN NAME OF

.....WARREN.....G.....CLAGGETT.....

Surveyed AUG.....1..... 1988, by Z.F...SALEH.....