


T8S, R4W, WM

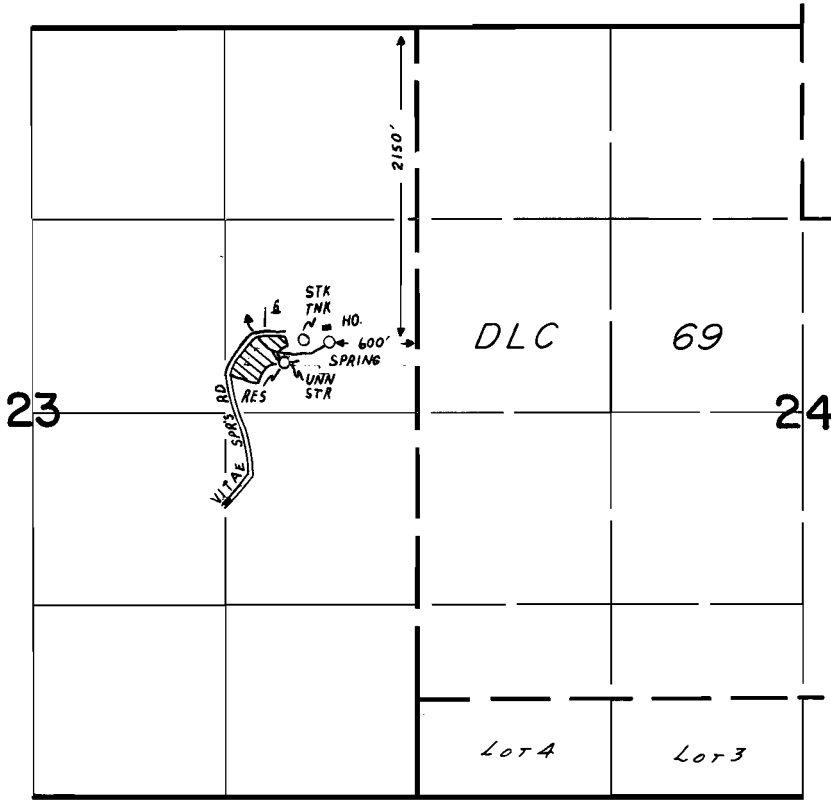

1" = 1320

RES. IS LOCATED 2290' S AND 910' W FROM THE NE CORNER SECTION 23

FINAL PROOF SURVEY
UNDER

R-57748 R-7697
57749 43449
Application No. 57750 Permit No. 43516
IN NAME OF

WARREN G. CLAGGETT

Surveyed AUG. 1, 1988, by Z.F. SALEH