



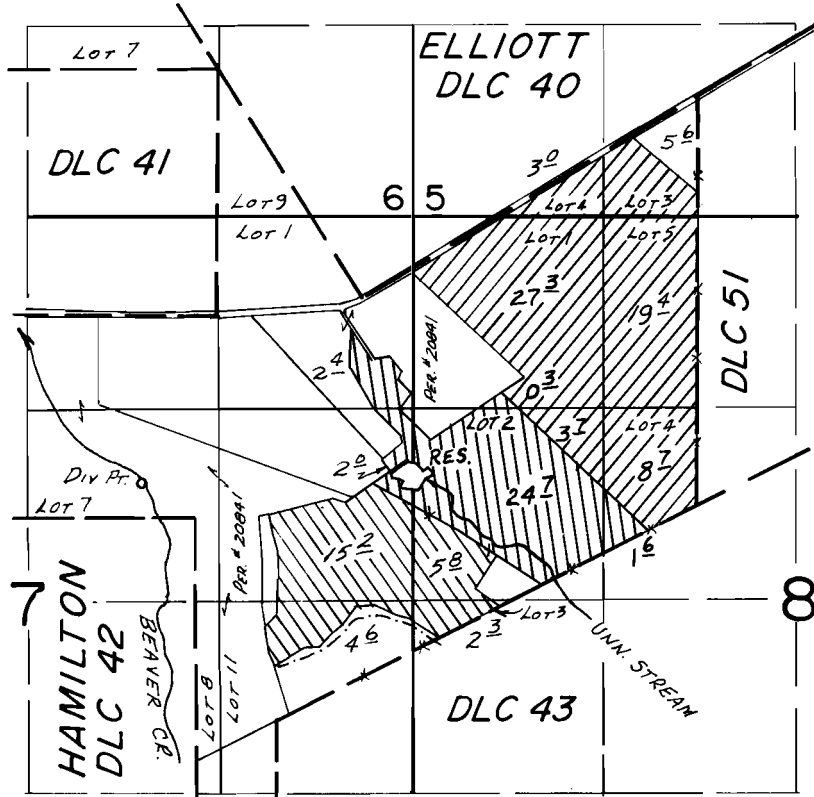

T. 11 S., R. 1 W., W.M.

 

FINAL PROOF SURVEY UNDER

-  TR. 3781
-  PER. 43922 (PRIMARY)
-  PER. 43922 (SUPPL.)

Transfer No. 3781
 R-57813 R-7795
 Application No. 57814 Permit No. 43922

IN NAME OF
 KENNETH & BETH NICHOLS dba
 NBAR S FRANCH

Surveyed MAY 28, 1982, by L. M. TOLL

Revised: 7-6-89

PTS 1982-Z & DFM-2D-175

JKL
SLB