


T.23S., R.5 W., W.M.

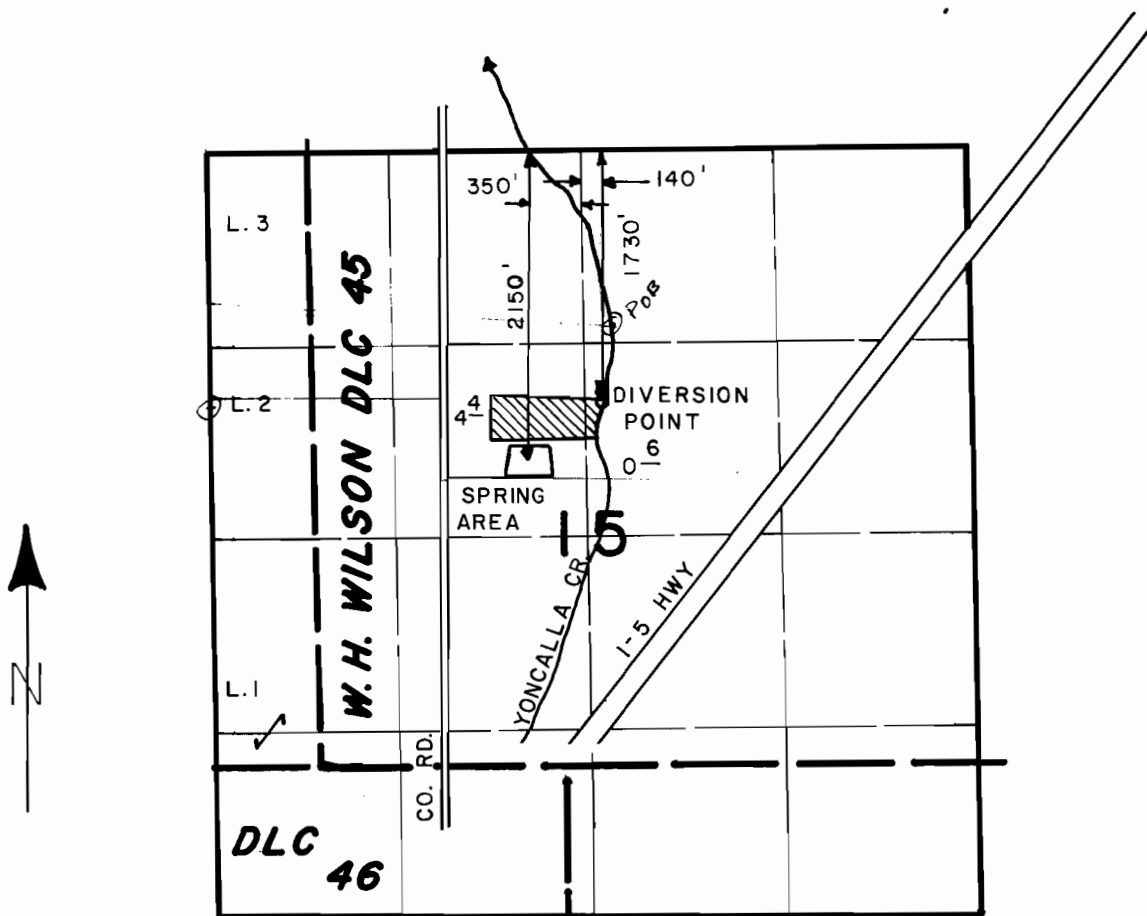

SCALE: 4" = 1 MILE

FINAL PROOF SURVEY
UNDER

Application No. 57904 Permit No. 43686
IN NAME OF

SHELVA J. FLACK-PETTY

Surveyed AUG. 16, 1988, by J.M. SCHMORDE