


T. 8S., R. 38E., W. M.

SCALE 1" = 400'

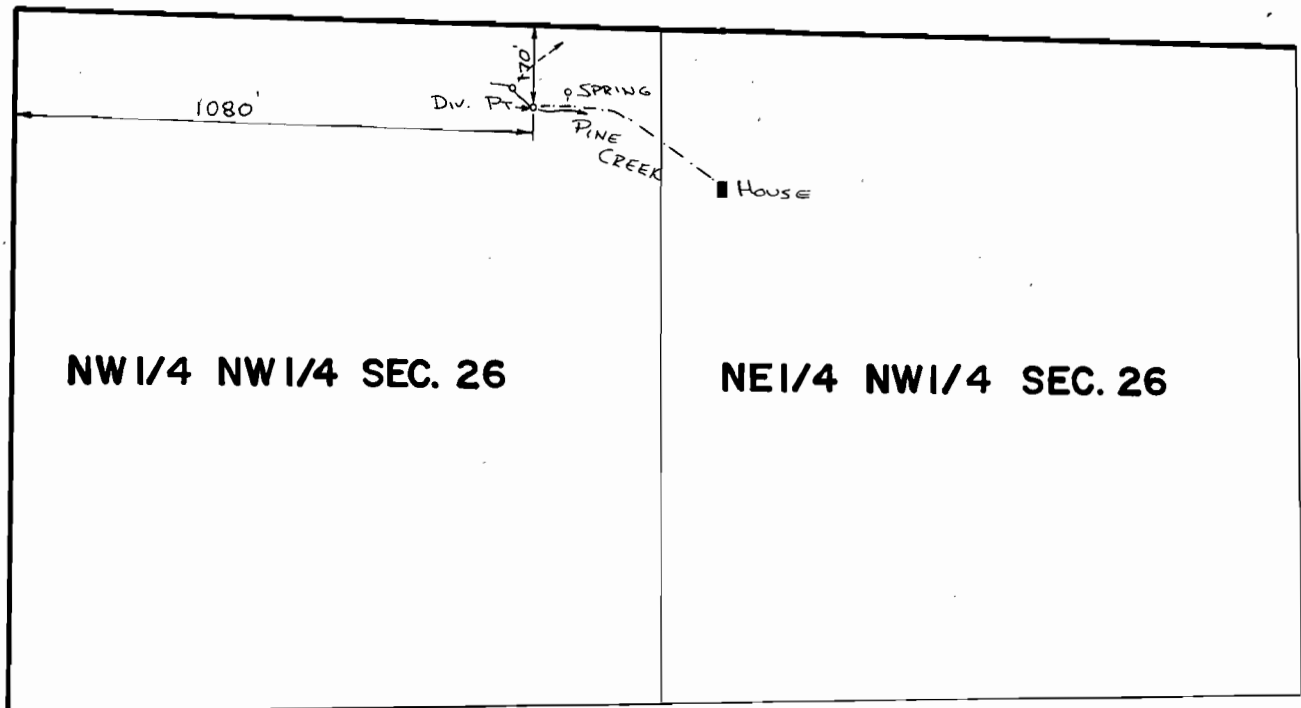

FINAL PROOF SURVEY
UNDER

Application No. **59350** Permit No. **44822**
IN NAME OF

RONALD E. DAVIS

Surveyed 4-15-1987, by V.L. Church