


Application No. R-59393
59394
Permit No. R 7960 & 44523

RECEIVED
OCT 11 1979
WATER RESOURCES DEPT
SALEM, OREGON

T4S R3E
SEC 17

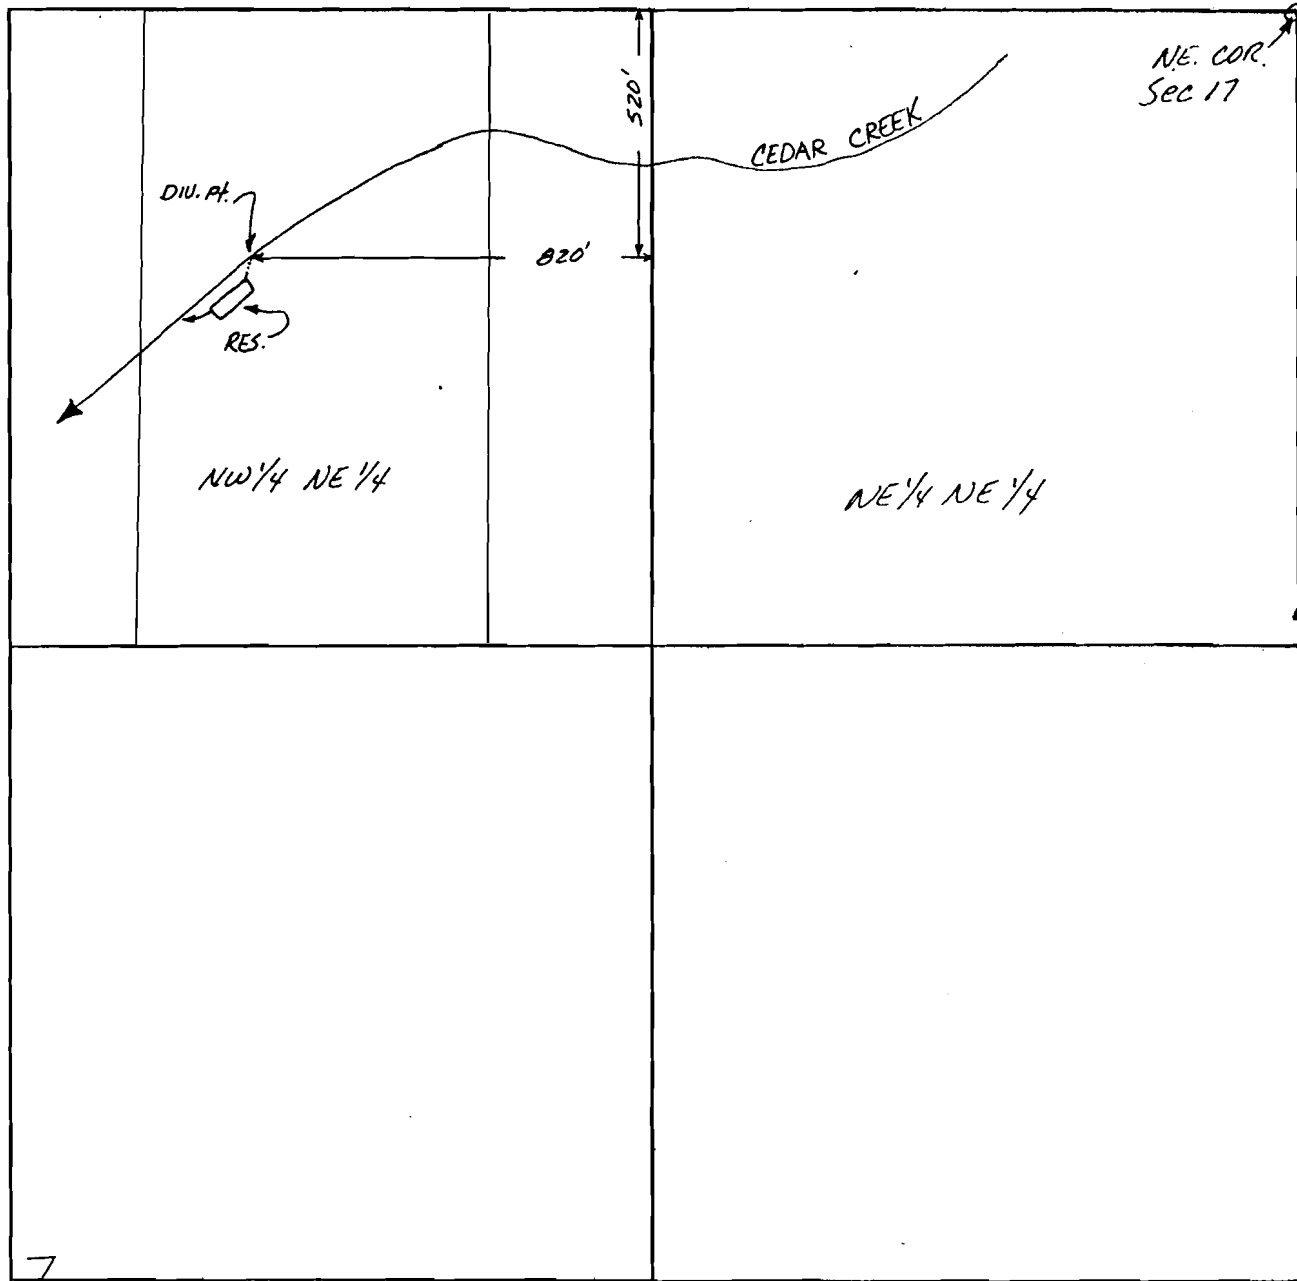

SCALE: 1" = 400'