


T. 30 S., R. 15 W., W.M.

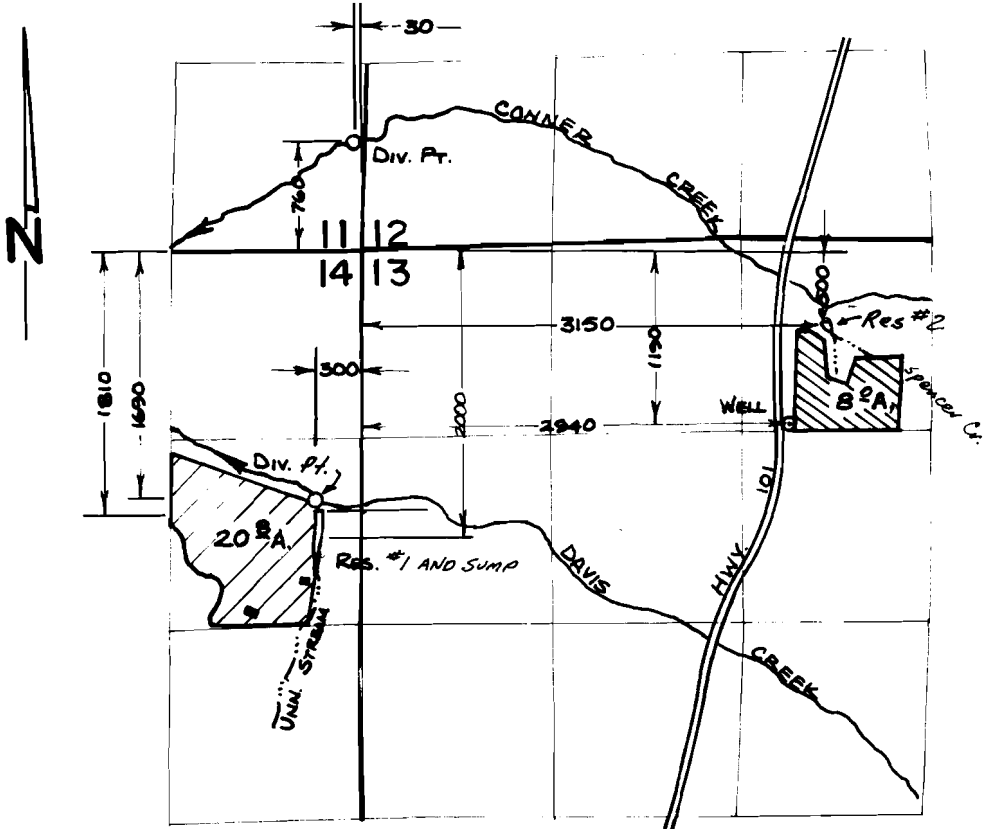


SCALE : 4" = 1 MILE

FINAL PROOF SURVEY UNDER

RG - 9494	G - 9088
59563	R - 8204
59564	45328
61757	46101
RG - 1296	G 10489
68151	R 10479
68023	49345
Application No. 68354	Permit No. 49429

IN NAME OF

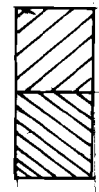

Sump
Reservoir
Unn. Stream & Reservoir
Davis Creek
Well
Spencer Creek Reservoir
Spencer Cr. & Res.
Conner Creek

HARRY G. SPENCER

Surveyed 7/26 & 28, 19.88, by J.J.M. SCHMORDE.