


T.I.S., R.10W., W.M.

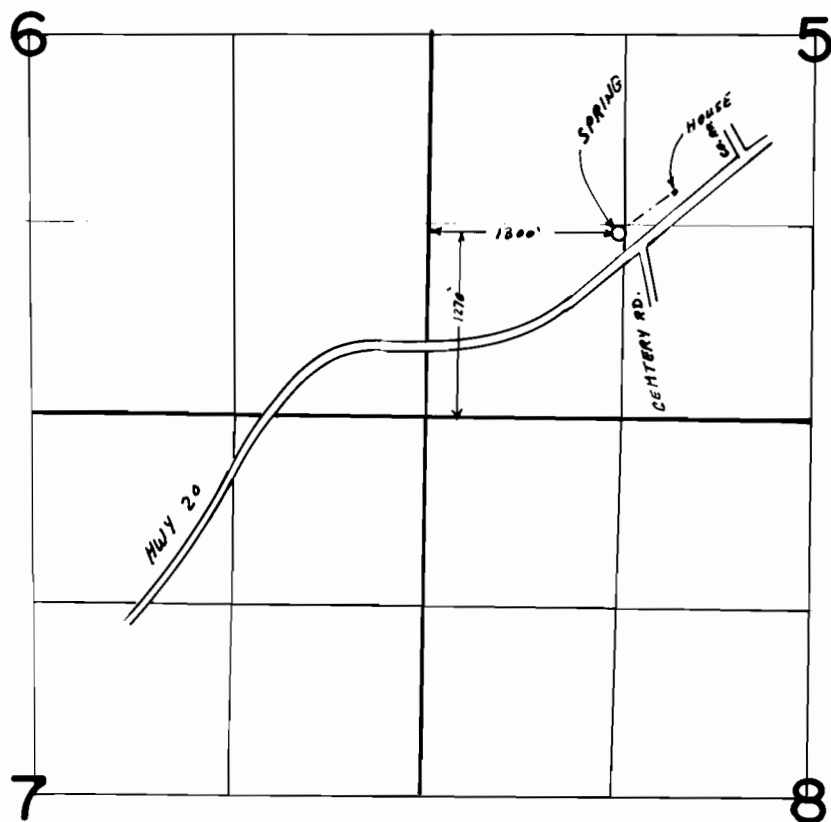

SCALE 1" = 1320'

FINAL PROOF SURVEY

UNDER

Application No. 59672 Permit No. 44858
IN NAME OF

KRAIG & KATHLEEN KELSON

Surveyed JUL.27.. 1988, by Z...SALEH.....

41041-272-52
5-26-89 Z.F.S.