


T. 18 S., R. 46 E., W. M.

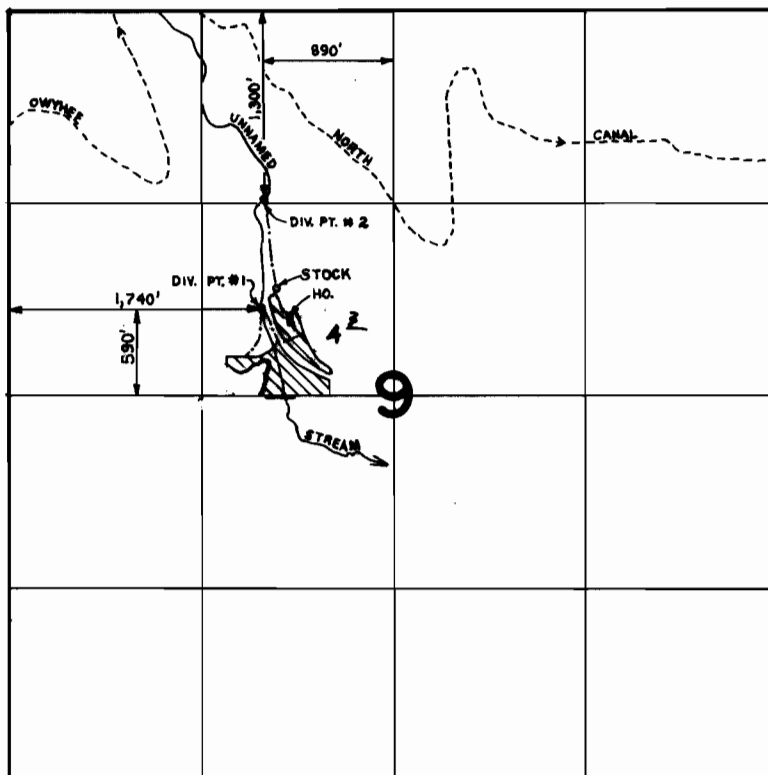

1" = 1,320'

FINAL PROOF SURVEY UNDER

Application No. 59687..... Permit No. 46320.....
IN NAME OF

.....**METLEN, ROBERT W.**.....

Surveyed **MARCH 3, 1986**., by **L.M. TOLL**.....