


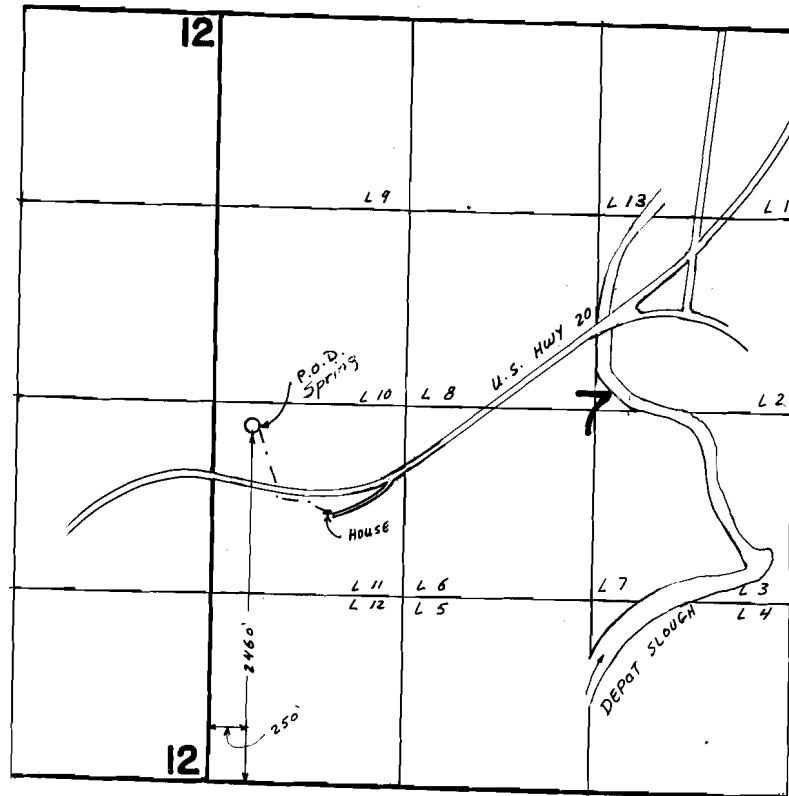

N

SCALE 1" = 1320'

FINAL PROOF SURVEY

UNDER

Application No. **60031** Permit No. **45552**
IN NAME OF

BURL PALMER SHOEMAKE

Surveyed JUL 27 88, by Z. SALEH

41041-272-2
5-18-89 Z. f. S.