




T. 7 S., R. 11 W., W.M.

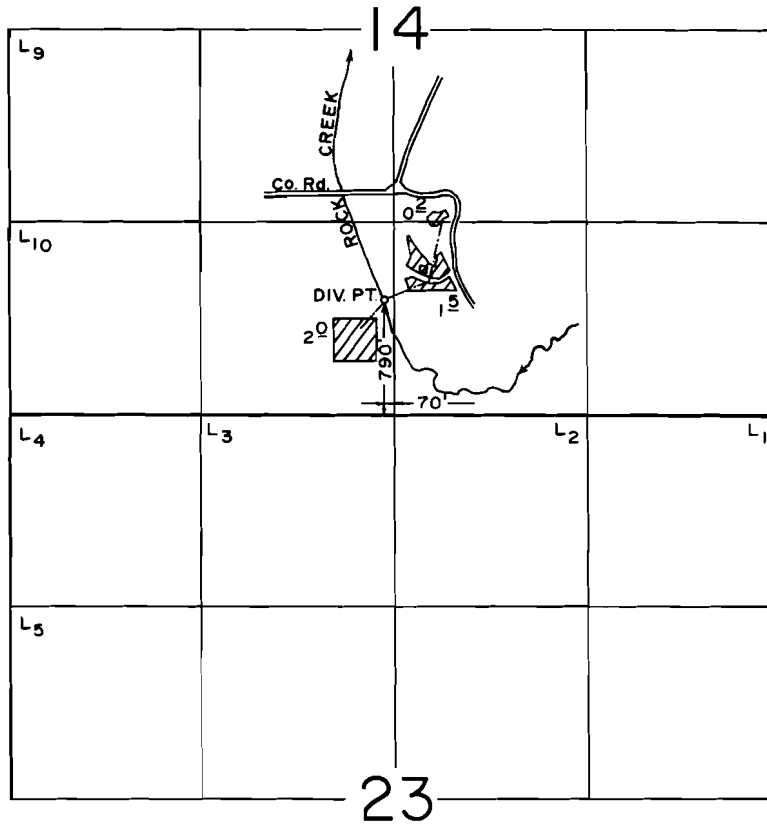

SCALE: 1" = 1320'

FINAL PROOF SURVEY
UNDER

Application No. 61073... Permit No. 45500...
IN NAME OF

.....JEFFERY A. JACKETS.....

Surveyed JUNE 17, 1986, by T. M. WARREN...