T.6S., R.1E., W.M.

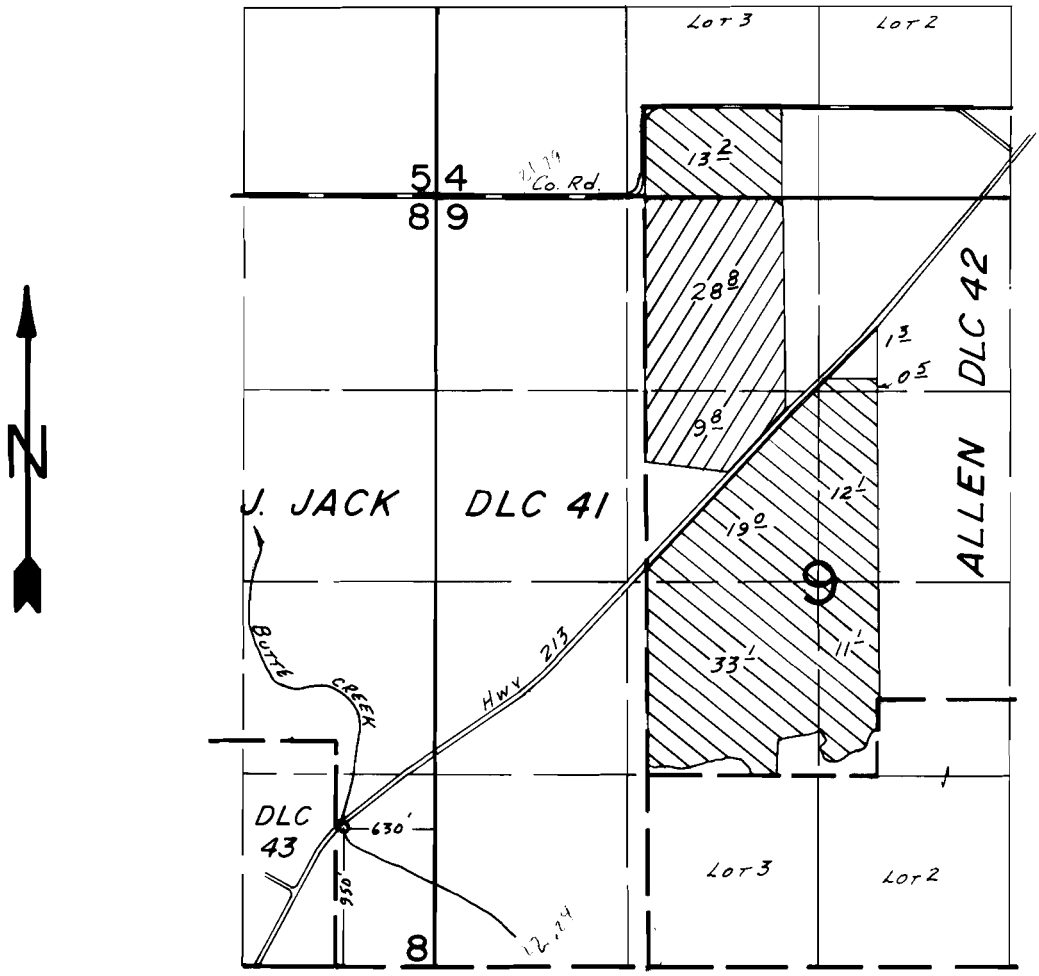

Primary
Supplemental

SCALE: 1" = 1320'

FINAL PROOF SURVEY

UNDER

Application No. 61721.... Permit No. 47800.....

IN NAME OF

HAROLD KRAEMER

Surveyed MAY 18 19 84, by B.W. BISHOP

41047 278 109B