


T. 30S., R. 4W., W.M.

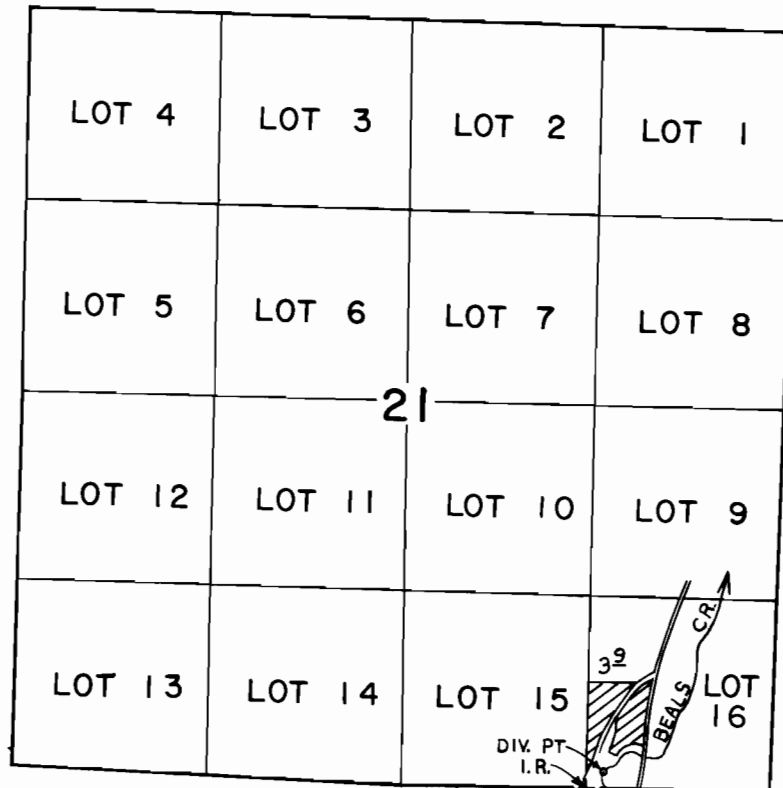

DIV. PT. LOCATED 130' N. & 1,140' W. FROM S.E. COR. SEC. 21

SCALE: 4" = 1 mile

FINAL PROOF SURVEY
UNDER

Application No. 61771... Permit No. 46094...
IN NAME OF

RUTH A. & MICHAEL S. STAFFORD

Surveyed AUG. 17, 1983, by J. S. DONALDSON