


T. 37S., R. 6W., W.M.

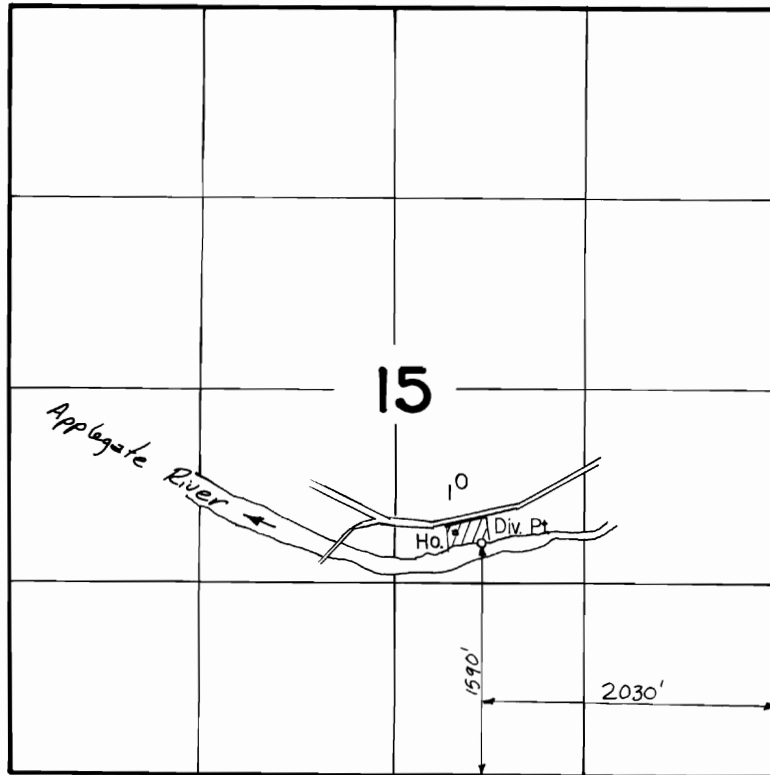

FINAL PROOF SURVEY
UNDER

TRANSFER No. 4876

Application No. 62362.. Permit No. 46522.....

IN NAME OF

JOHN & MARIA RADCLIFFE

Surveyed OCT. 19, 1983., by B. S. JAMES.....