




T. 2 S., R. 1 E., W.M.

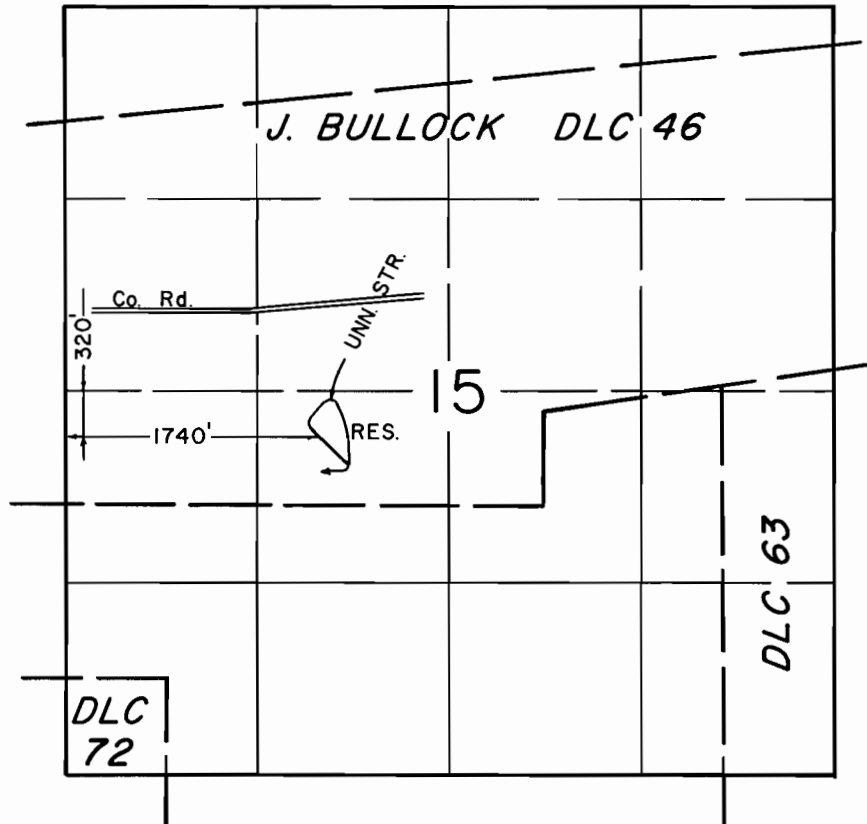

SCALE: 1" = 1320'

**FINAL PROOF SURVEY**  
UNDER

R-62431                      R-8382  
Application No. 62432 Permit No. 46572.....  
IN NAME OF

.....LAWRENCE S. BLACK.....

Surveyed SEPT. 3. 1986., by T. M. WARREN..