




T.5 S., R.1 W. & 1 E., W.M.

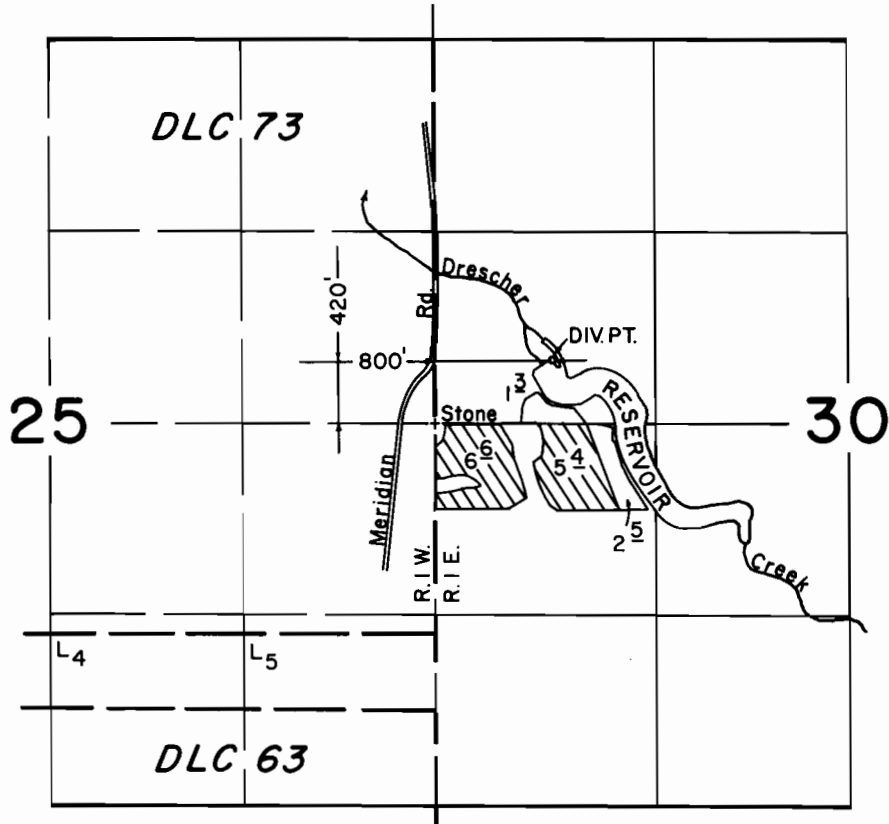

SCALE: 1" = 1320'

FINAL PROOF SURVEY UNDER

Application No. 63243. Permit No. 46497
IN NAME OF

EDWARD DRESCHER

Surveyed JUNE 25 1986, by T. M. WARREN...