


# T. 4S., R5W., W. M.

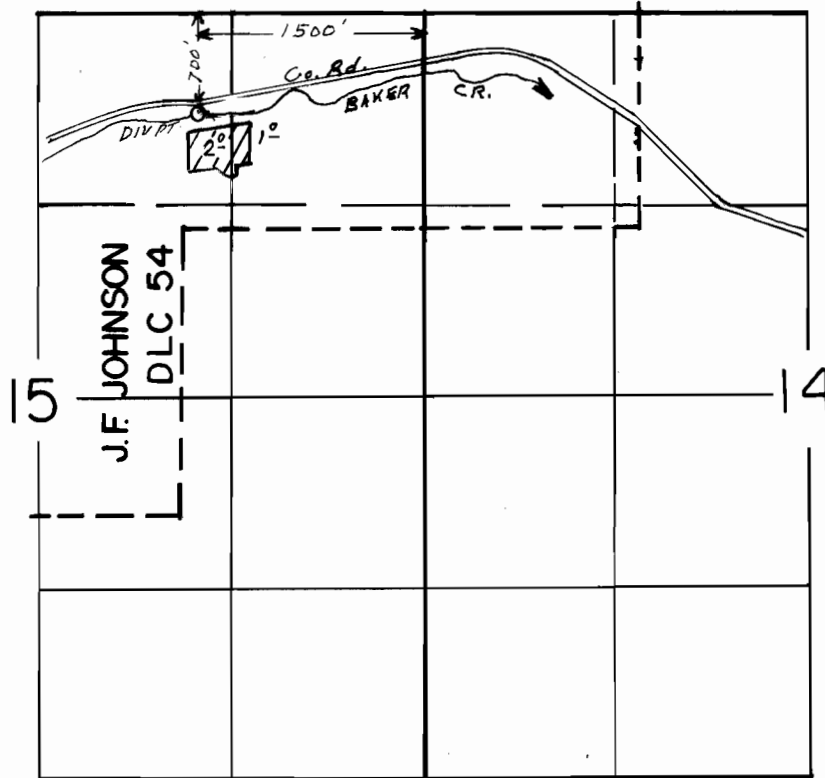

SCALE: 1" = 1320'

## FINAL PROOF SURVEY UNDER

Application No. 63514 Permit No. 47305  
IN NAME OF

ALFRED J & MARSHA L PEIRISH

Surveyed SEPT. 29. 19.88., by J.C. LARSON